

CODED

MISSISSIPPI  
BOARD OF WATER COMMISSIONERS  
416 North State Street  
Jackson, Mississippi 39201

WATER WELL DRILLERS LOG

Newton  
C19  
12-31-69

Dec 31 1969 Mc Donald Hill Inc Newton  
date well completed firm name county well located

LANDOWNER Mr. Pearson  
UNION Miss

description of formations encountered	from	to
Clay	0	20
Sandy st rock	20	60
Surface sand	60	75
st rock + shell	75	170
st fine sand	170	185
course sand	185	200
fine sand	200	220
Coarse sand	220	225
fine sand	225	230

(mailing address)

WELL LOCATION:  
sec 16 T 8 N R 12 E  
2 1/2 miles west of Little Rock  
(distance) (direction) (nearest town)

WELL PURPOSE: none  
(home, irrigation, municipal, industrial)

- WELL COMPLETION DATA:
- (1) diameter (inches) 4
  - (2) total depth (feet) 230
  - (3) static water level (feet) 152 below top of ground.
  - (4) casing 4" black, 16' (material) (depth),  
no (size) if telescope see back.
  - (5) screen no, (length) (depth to top),  
no (size) (material)
  - (6) pump 3/4" 3 (HP) (yield gpm)  
Red (type power)
  - (7) electric log no (yes or no)  
no (organization running log)
  - (8) how well bottom plugged open


DRILLERS REMARKS: none

JAN - 5 1970

MISS. Bd. of WATER COMMISSIONERS

If well telescopes please sketch and show depths.

GROUND LEVEL

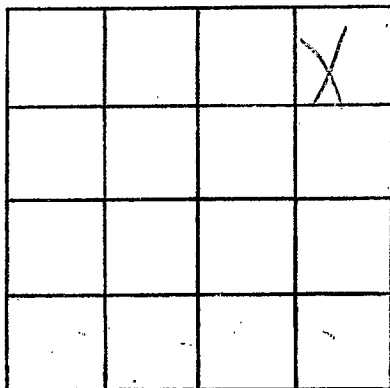

SECTION 16

Please indicate well location X.

ADDITIONAL INFORMATION

If more than one screen, show locations of each on sketch.