

Newton
C 23
5-6-70

MISSISSIPPI
 BOARD OF WATER COMMISSIONERS
 416 North State Street
 Jackson, Mississippi 39201

CODED

WATER WELL DRILLERS LOG

5-6 1970 R.R. Nicholson Newton
 date well completed firm name county well located

LANDOWNER:	description of formations	from	to
<u>Gordon Watkins</u>	<u>Chalk & Clay</u>	<u>0</u>	<u>32</u>
<u>Union</u>	<u>Miss. Sandstone</u>	<u>32</u>	<u>40</u>
<u>Miss.</u>	<u>Chalky Sand</u>	<u>40</u>	<u>60</u>
(mailing address)	<u>Blue dirt</u>	<u>60</u>	<u>150</u>
WELL LOCATION:	<u>Water Sand</u>	<u>150</u>	<u>187</u>
sec. <u>15</u> T <u>8</u> N R <u>12</u> E			
<u>4 1/2</u> miles <u>South</u> of <u>Union</u>			
(distance) (direction) (nearest town)			
WELL PURPOSE: <u>industrial</u>			
(home, irrigation, municipal, industrial)			
WELL COMPLETION DATA:			
(1) diameter (inches) <u>6 1/2</u>			
(2) total depth (feet) <u>189</u>			
(3) static water level (feet) <u>105</u> below above top of ground.			
(4) casing <u>galv.</u> <u>163</u> (material) (depth)			
<u>4"</u> if telescope see back. (size)			
(5) screen <u>24</u> <u>187</u> (length) (depth to top)			
<u>2"</u> <u>steel</u> (size) (material)			
(6) pump <u>3</u> <u>50</u> (HP) (yield gpm)			
<u>Elect.</u> (type power)			
(7) electric log <u>No</u> (yes or no)			
(organization running log)			
(8) how well bottom plugged <u>Screen</u>			
DRILLERS REMARKS:			


CODED

JUL 24 1970

MISS. BD. OF WATER COMMISSIONERS

If well telescopes please sketch and show depths.

GROUND LEVEL

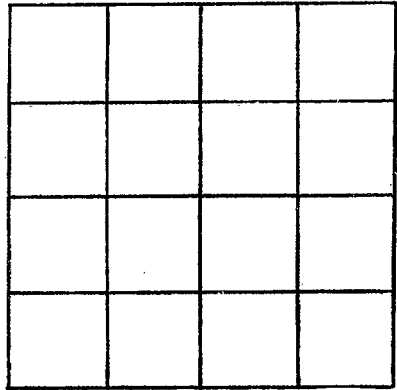

SECTION _____

Please indicate well location X.

ADDITIONAL INFORMATION

If more than one screen, show locations of each on sketch.