

**NEWTON**  
**C24**  
**8-3-70**

MISSISSIPPI  
 BOARD OF WATER COMMISSIONERS  
 416 North State Street  
 Jackson, Mississippi 39201

**CODED**

**WATER WELL DRILLERS LOG**

8.3.70 19 McDONALD + HILL NEWTON  
 date well completed firm name county well located

**LANDOWNER:**  
BUCK TERRELL  
R#2 DECATOR  
 (mailing address)

**WELL LOCATION:**  
 sec 29 T. 8 N. R. 12 E  
5 miles NORTH of DECATOR  
 (distance) (direction) (nearest town)

**WELL PURPOSE:** HOME  
 (home, irrigation, municipal, industrial)

- WELL COMPLETION DATA:**
- (1) diameter (inches) 4"
  - (2) total depth (feet) 250'
  - (3) static water level (feet) 92' <sup>below</sup> ~~above~~ top of ground.
  - (4) casing BLK 126'  
 (material) (depth)  
4"  
 (size) if telescope see back.
  - (5) screen                    
 (length) (depth to top)  
                   
 (size) (material)
  - (6) pump 1/2 10  
 (HP) (yield gpm)  
220  
 (type power)
  - (7) electric log NO  
 (yes or no)  
          
 (organization running log)
  - (8) how well bottom plugged OPEN

description of formations encountered	from	to
CLAY	0	18
SAND	18	30
SHALE	30	56
ROCK ST SHALE	56	80
SAND	80	120
SHALE	120	140
SAND	140	160
ROCK ST SHALE	160	210
SAND	210	250


**CODED**

DRILLERS REMARKS:         

AUG 6 1970

If well telescopes please sketch and show depths.

GROUND LEVEL

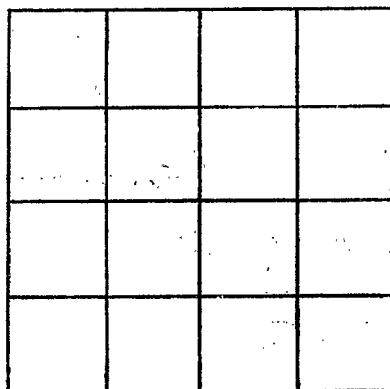

SECTION \_\_\_\_\_

Please indicate well location X.

ADDITIONAL INFORMATION

If more than one screen,  
show locations of each on sketch.