

NEWTON
C25
7-31-70
 197-31-70
 date well completed

MISSISSIPPI
 BOARD OF WATER COMMISSIONERS
 416 North State Street
 Jackson, Mississippi 39201

CODED

WATER WELL DRILLERS LOG

R B Nicholson Newton
 firm name county well located

LANDOWNER: Mike Hathorn
Union
Miss
 (mailing address)

description of formations encountered	from	to
<u>Clay</u>	<u>0</u>	<u>20</u>
<u>green cherty clay</u>	<u>20</u>	<u>40</u>
<u>water sand</u>	<u>40</u>	<u>52</u>

WELL LOCATION:
 sec. 7 T. 8 N. R. 12 E.
1 1/2 miles South of Union
 (distance) (direction) (nearest town)

WELL PURPOSE:
 (home, irrigation, municipal, industrial)

WELL COMPLETION DATA:
 (1) diameter (inches) 4 1/4
 (2) total depth (feet) 52
 (3) static water level (feet) 38 below above top of ground.
 (4) casing galv. 47
 (material) (depth)
2" if telescope see back.
 (size)
 (5) screen 5 52
 (length) (depth to top)
1/4 Steel
 (size) (material)
 (6) pump 1/2 10
 (HP) (yield gpm)
Elect.
 (type power)
 (7) electric log no
 (yes or no)
 (organization running log)
 (8) how well bottom plugged Screen

CODED


DEC 15 1970

MISS. BD OF
 WATER COM.

DRILLERS REMARKS:

If well telescopes please sketch and show depths.

GROUND LEVEL

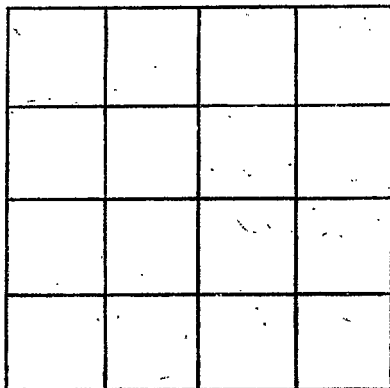

SECTION _____

Please indicate well location X.

ADDITIONAL INFORMATION

If more than one screen, show locations of each on sketch.