

NEWTON  
C 26  
8-12-70

MISSISSIPPI  
BOARD OF WATER COMMISSIONERS  
416 North State Street  
Jackson, Mississippi 39201

**CODED**

WATER WELL DRILLERS LOG

8-12-70 1970 B. B. Nicholas Newton  
date well completed firm name county well located

LANDOWNER: B. B. Nicholas  
Newton  
Miss.  
(mailing address)

description of formations encountered	depth	
	from	to
Clay	0	20
Chalk & clay	20	40
Hard sand with	40	70
Blue sand	70	87

WELL LOCATION:  
sec. 7 T. 8 N. R. 12 E  
2 miles South of Newton  
(distance) (direction) (nearest town)

WELL PURPOSE: Domestic  
(home, irrigation, municipal, industrial)

- WELL COMPLETION DATA:
- (1) diameter (inches) 4 1/4
  - (2) total depth (feet) 87
  - (3) static water level (feet) 70 below above top of ground.
  - (4) casing Galv. 84 (material) (depth)  
2" if telescope see back. (size)
  - (5) screen 5' 87 (length) (depth to top)  
1/4" steel (size) (material)
  - (6) pump 1HP 11 (HP) (yield gpm)  
Electric (type power)
  - (7) electric log                       
(organization running log)
  - (8) how well bottom plugged Screen

**CODED**


DEC 15 1970

MISS. BD. OF  
WATER COMMISSIONERS

DRILLERS REMARKS:

If well telescopes please sketch and show depths.

GROUND LEVEL

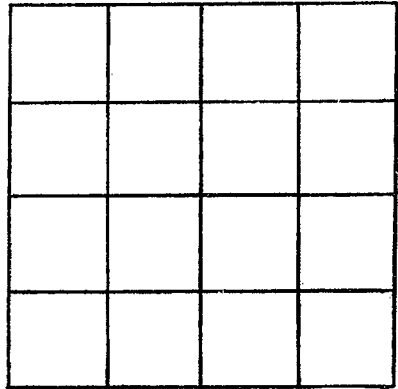

SECTION \_\_\_\_\_

Please indicate well location X.

ADDITIONAL INFORMATION

If more than one screen, show locations of each on sketch.