

NEWTON  
C27  
12-2-70

MISSISSIPPI  
 BOARD OF WATER COMMISSIONERS  
 416 North State Street  
 Jackson, Mississippi 39201

**CODED**

WATER WELL DRILLERS LOG

12-2 date well completed      1970 B B Nicholas firm name      Newton county well located

LANDOWNER: Hugh Matheny  
Union  
Miss.  
 (mailing address)

description of formations encountered	from	to
<u>Chalk</u>	<u>0</u>	<u>12</u>
<u>Chalk &amp; bluish</u>	<u>12</u>	<u>40</u>
<u>min. sand &amp; dirt</u>	<u>40</u>	<u>46</u>
<u>Water Sand</u>	<u>46</u>	<u>52</u>

WELL LOCATION:  
 sec. 21 T. 8 N. R. 12 E.  
5 miles S-W of Union  
 (distance) (direction) (nearest town)

WELL PURPOSE: home  
 (home, irrigation, municipal, industrial)

- WELL COMPLETION DATA:
- (1) diameter (inches) 4 1/4
  - (2) total depth (feet) 52
  - (3) static water level (feet) 39 below top of ground.
  - (4) casing galv. 47  
 (material) (depth)  
2" if telescope see back.  
 (size)
  - (5) screen 5' 52  
 (length) (depth to top)  
1/4" Steel  
 (size) (material)
  - (6) pump 1 H  
 (HP) (yield gpm)  
Elect.  
 (type power)
  - (7) electric log \_\_\_\_\_  
 (yes or no)
  - \_\_\_\_\_ (organization running log)
  - (8) how well bottom plugged \_\_\_\_\_

**CODED**


DEC 15 1970

DRILLERS REMARKS: \_\_\_\_\_

MISS. BD. OF  
 WATER COMM.

If well telescopes please sketch and show depths.

GROUND LEVEL

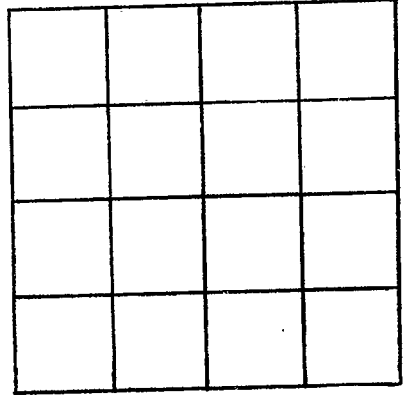

SECTION \_\_\_\_\_

Please indicate well location X.

ADDITIONAL INFORMATION

If more than one screen,  
show locations of each on sketch.