

~~NEWTON~~

MISSISSIPPI BOARD OF WATER COMMISSIONERS

OC29

6 13 P
CODED WATER WELL DRILLERS LOG

CODED
Newton

4-19-61

Date: 4/19, 19 61, Driller: Hester Ogletree County: Newton
(Name)

(1) Owner of Land: D.O. Smith
(Name)
Union, Miss.
(Address)

Description & Color of Materials
Sand, Clay, Red Clay, Shell, etc.

Thick-
ness
Feet

Depth
Feet

8 ft clay 3 ft sand

(2) Location: 1/4, 1/4, Sec. 3 T8 R12
5 miles east of Union
(distance) (direction) (Nearest Town)

(3) Topography: Hilly
(Hilly) (Flat) (Level)

(4) Purpose of Well: Home use
(Domestic Irrigation
Municipal, Industrial, Other)

Information upon completion of well:

- (1) Diameter 4 inches.
- (2) Total Depth 29 feet.
- (3) Water Level 7 feet below top of ground.
- (4) Cased to 33, Size 2 in.
- (5) Screen: Size 1 1/2, Length 6 ft.
- (6) Were any formations sealed against pollution?

CODED


yes, no.

CODED

If YES depth of formation

Why

Drillers Remarks:

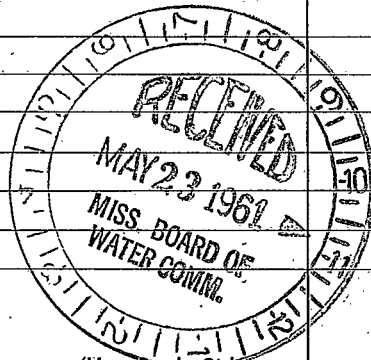

(Use Back-Side)

Well No.

tain this copy for your office files.

