

Newton
C 30
7-26-71

MISSISSIPPI
 BOARD OF WATER COMMISSIONERS
 416 North State Street
 Jackson, Mississippi 39201

CODED

WATER WELL DRILLERS LOG

7-26 1971 R B Nicholson Newton
 date well completed firm name county well located

LANDOWNER: Best James
Union
Miss -
 (mailing address)

description of formations encountered	from	to
Clay	0	15
mix dirt/sand	17	30
blue dirt	30	100
rock	100	103
blue dirt & sand	103	140
water sand	140	152

WELL LOCATION:
 sec. 4 T 8 N R 12 E
2 miles west of Union
 (distance) (direction) (nearest town)

WELL PURPOSE: home
 (home, irrigation, municipal, industrial)

- WELL COMPLETION DATA:
- (1) diameter (inches) 4 1/4"
 - (2) total depth (feet) 152'
 - (3) static water level (feet) 109 below above top of ground.
 - (4) casing Lead, 147'
 (material) (depth)
2" If telescope see back.
 (size)
 - (5) screen 5', 152'
 (length) (depth to top)
1/4", steel
 (size) (material)
 - (6) pump 1/2, 4
 (HP) (yield gpm)
Elect
 (type power)
 - (7) electric log no
 (yes or no)

 (organization running log)
 - (8) how well bottom plugged _____

CODED


DRILLERS REMARKS:

NOV 2 1971

MISSISSIPPI
 BOARD OF WATER COMMISSIONERS

If well telescopes please sketch and show depths.

GROUND LEVEL

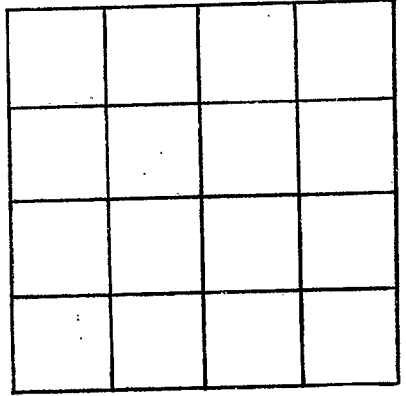

SECTION _____

Please indicate well location X.

ADDITIONAL INFORMATION

If more than one screen, show locations of each on sketch.