

Newton

C 31

9-22-71

MISSISSIPPI
 BOARD OF WATER COMMISSIONERS
 416 North State Street
 Jackson, Mississippi 39201

CODED

WATER WELL DRILLERS LOG

9-22
date well completed

71 RB Nicholson
firm name

Newton
county well located

LANDOWNER: Jerry Nicholson
 Union
 Miss -
 (mailing address)

description of formations encountered	from	to
Clay & Chalk	0	23
sand Chalk	23	45
water Sand	45	58

WELL LOCATION:
 sec. 7 T 8 N R 12 E
 S W
 3 miles South of Union
 (distance) (direction) (nearest town)

WELL PURPOSE: home
 (home, irrigation, municipal, industrial)

- WELL COMPLETION DATA:
- (1) diameter (inches) 4 1/4"
 - (2) total depth (feet) 58'
 - (3) static water level (feet) 38 below above top of ground.
 - (4) casing Lead, 53',
 (material) (depth)
2" If telescope see back.
 (size)
 - (5) screen 5', 58'
 (length) (depth to top)
1 1/4", Steel
 (size) (material)
 - (6) pump 1 10
 (HP) (yield gpm)
Elect
 (type power)
 - (7) electric log no
 (yes or no)
- (organization running log)
- (8) how well bottom plugged

CODED


DRILLERS REMARKS:

NOV 19 1971

MISSISSIPPI BOARD OF WATER COMMISSIONERS

If well telescopes please sketch and show depths.

GROUND LEVEL

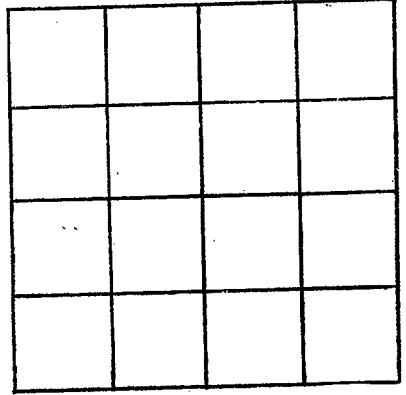

SECTION _____

Please indicate well location X.

ADDITIONAL INFORMATION

If more than one screen, show locations of each on sketch.