

Newton
C 33
7-13-72

MISSISSIPPI
 BOARD OF WATER COMMISSIONERS
 416 North State Street
 Jackson, Mississippi 39201

CODED

WATER WELL DRILLERS LOG

7-13 1972 U.L. Shelch Newton
 date well completed firm name county well located

LANDOWNER: Frank Wiles
Decatur
Miss
 (mailing address)

description of formations encountered	from	to
<u>Yellow clay</u>	<u>0</u>	<u>18</u>
<u>Blue + sandy</u>	<u>18</u>	<u>40</u>
<u>Rocky + Blue</u>	<u>40</u>	<u>140</u>
<u>Brown</u>	<u>140</u>	<u>165</u>
<u>Sand</u>	<u>165</u>	<u>180</u>

WELL LOCATION:
 sec. 33 T. 8 N. R. 12 E.
5 miles NE of Decatur
 (distance) (direction) (nearest town)

WELL PURPOSE: Home
 (home, irrigation, municipal, industrial)

- WELL COMPLETION DATA:
- (1) diameter (inches) 2"
 - (2) total depth (feet) 200
 - (3) static water level (feet) 38 below top of ground
 - (4) casing Gal Steel 8x
 (material) (depth)
 (size) if telescope see back.
 - (5) screen Open Hole
 (length) (depth to top)
 (size) (material)
 - (6) pump 3 400
 (HP) (yield gpm)
elec
 (type power)
 - (7) electric log NO
 (yes or no)
 (organization running log)
 - (8) how well bottom plugged

CODED


JUL 31 1972

MISS. DR. LOG
 10-100000-100000

DRILLERS REMARKS:
Open Hole

If well telescopes please sketch and show depths.

GROUND LEVEL

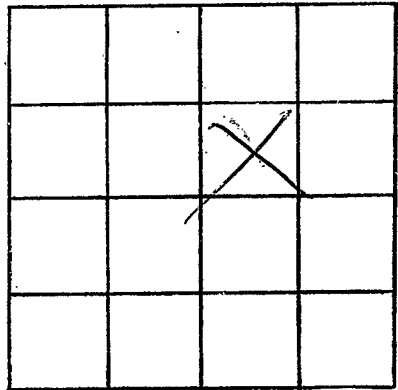

SECTION _____

Please indicate well location X.

ADDITIONAL INFORMATION

If more than one screen,
show locations of each on sketch.