

NEWTON
C35
7-24-73

MISSISSIPPI
 BOARD OF WATER COMMISSIONERS
 416 North State Street
 Jackson, Mississippi 39201

WATER WELL DRILLERS LOG

CODED

7-24-73 date well completed
 McDonald + Hill firm name
 NEWTON county well located

LANDOWNER:
 ORANCE ETHRIDGE
 UNION
 (mailing address)

WELL LOCATION:
 sec. 3 T. 8^N R. 12^W
 2 miles EAST of UNION
 (distance) (direction) (nearest town)

WELL PURPOSE: HOME
 (home, irrigation, municipal, industrial)

- WELL COMPLETION DATA:
- (1) diameter (inches) 4 1/2
 - (2) total depth (feet) 320
 - (3) static water level (feet) 150 below top of ground.
 - (4) casing PVC, 280 (material), (depth)
4 1/2 (size) if telescope see back.
 - (5) screen 10, 290 (length), (depth to top)
2" (size), PVC (material)
 - (6) pump 34 sub 10 (HP), (yield gpm)
220 (type power)
 - (7) electric log NO (yes or no)
NO (organization running log)
 - (8) how well bottom plugged VALVE

description of formations encountered	from	to
CLAY	0	10
SAND	10	55
SOFT SHALE	55	100
SAND	100	155
SHALE ST. ROCK	155	195
SAND	195	235
SHALE	235	290
SAND	290	320


CODED

JUL 30 1973

DRILLERS REMARKS:

If well telescopes, please sketch and show depths.

GROUND LEVEL

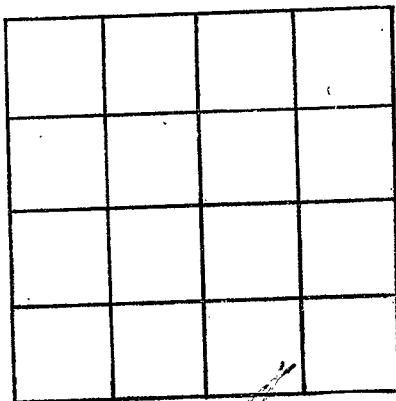

SECTION _____

Please indicate well location X.

ADDITIONAL INFORMATION

If more than one screen, show locations of each on sketch.