

145

C 36
NEWTON
5-11-73

MISSISSIPPI
BOARD OF WATER COMMISSIONERS
416 North State Street
Jackson, Mississippi 39201

CODED

WATER WELL DRILLERS LOG

5-11 1973 Common Drilling Newton
date well completed firm name county well located

LANDOWNER: Roger Tolson
Permit # 2
Miss
(mailing address)

description of formations encountered	from	to
<u>Gravel</u>	<u>0</u>	<u>40</u>
<u>Rock almost solid</u>	<u>40</u>	<u>130</u>
<u>Rock + Sand ledges</u>	<u>130</u>	<u>294</u>
<u>Sand</u>	<u>294</u>	<u>288</u>

WELL LOCATION:
sec. 7 T. 8 N. R. 12 E
7 miles E of Permit
(distance) (direction) (nearest town)

WELL PURPOSE: Home
(home, irrigation, municipal, industrial)

WELL COMPLETION DATA:

- (1) diameter (inches) 2"
- (2) total depth (feet) 288
- (3) static water level (feet) 70 below above top of ground.
- (4) casing Steel, 283,
(material) (depth)
5 If telescope see back.
(size)
- (5) screen 5,
(length) (depth to top)
2", Stamper Steel
(size) (material)
- (6) pump 1, 5
(HP) (yield gpm)
Electric
(type power)
- (7) electric log Yes
(yes or no)

(organization running log)

(8) how well bottom plugged B Work


DRILLERS REMARKS:

CODED

AUG 20 1973

If well telescopes please sketch and show depths.

GROUND LEVEL

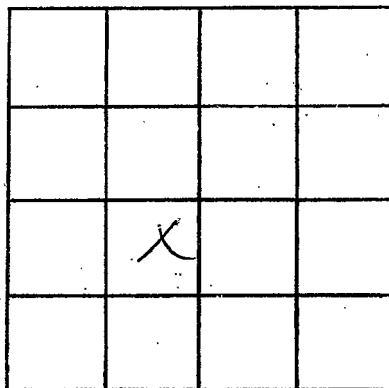

SECTION _____

Please indicate well location X.

ADDITIONAL INFORMATION

If more than one screen, show locations of each on sketch.