

NEWTON

C38

11/22/74

MISSISSIPPI  
 BOARD OF WATER COMMISSIONERS  
 416 North State Street  
 Jackson, Mississippi 39201

CODED

WATER WELL DRILLERS LOG

11-22-74  
date well completed

19 McDONALD & HILL  
firm name

NEWTON  
county well located

LANDOWNER:

DENVER BRACKEN

R# 2 DECATUR  
(mailing address)

WELL LOCATION:

sec. 18 T. 8 N. R. 12 E.  
 S W  
 2 miles SOUTH of UNION  
 (distance) (direction) (nearest town)

WELL PURPOSE: HOME  
(home, irrigation, municipal, industrial)

WELL COMPLETION DATA:

- (1) diameter (inches) 4"
- (2) total depth (feet) 60'
- (3) static water level (feet) 20' below above top of ground.
- (4) casing PVC, 35',  
4" if telescope see back.  
(size)
- (5) screen \_\_\_\_\_  
(length) (depth to top)  
(size) (material)
- (6) pump 1/2 sub 10  
(HP) (yield gpm)  
ELECTRIC  
(type power)
- (7) electric log \_\_\_\_\_  
(yes or no)  
(organization running log)
- (8) how well bottom plugged OPEN

description of formations encountered

from to

CLAY

0 16

SAND + CLAY

16 32

SHALE

32 40

SAND

40 58

CODED


DECLARED  
 NOV 29 1974

DRILLERS REMARKS:

MISS. RD. OF WATER COMMISSIONERS

If well telescopes please sketch and show depths.

GROUND LEVEL

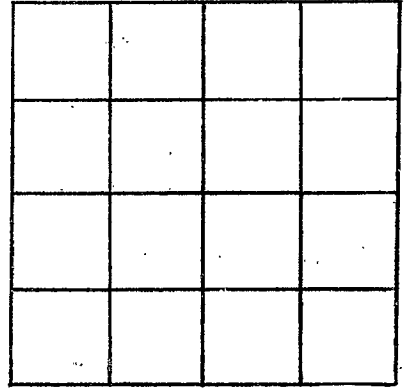

SECTION \_\_\_\_\_

Please indicate well location X.

ADDITIONAL INFORMATION

If more than one screen,  
show locations of each on sketch.