

NEWTON
C39
8-20-79

MISSISSIPPI
 BOARD OF WATER COMMISSIONERS
 416 North State Street
 Jackson, Mississippi 39201

CODED


WATER WELL DRILLERS LOG

AUGUST 20 1979 HAROLD POOLE NEWTON
 date well completed firm name county well located

LANDOWNER:	description of formations encountered	from	to
CALVIN ALDAY RT 1 BOX 119 COLLINSVILLE, MISS-39325 (mailing address)	Red CLAY and ROCK	0'	10'
WELL LOCATION: sec. <u>5</u> T <u>8</u> N R <u>12</u> E <u>out</u> <u>5</u> <u>W</u> EDGE of miles EAST of UNION (distance) (direction) (nearest town)	SAND-YELLOW + BROWN.	10'	58'
WELL PURPOSE: FISH POND (home, irrigation, municipal, industrial)	BLUE SHADED AND ROCK in LAYERS	58'	110'
WELL COMPLETION DATA: (1) diameter (inches) <u>4 inches</u>	COARSE WHITE SAND	110'	129'
(2) total depth (feet) <u>270 ft</u>			
(3) static water level (feet) <u>126</u> below top of ground.	BLUE SHELL AND ROCK in LAYERS	129'	183'
(4) casing <u>PVC</u> <u>158</u> (material) (depth)			
_____ if telescope see back. (size)	SAND-MEDIUM FINE WITH LAYERS OF THIN SHELL ROCK OFF + ON		183'
(5) screen <u>OPEN</u> (length) (depth to top)			270'
_____ (size) _____ (material)			
(6) pump <u>1 SUB</u> <u>17.5</u> (HP) (yield gpm)			
<u>220 ELECTRIC</u> (type power)			
(7) electric log _____ (yes or no)			
_____ (organization running log)			
(8) how well bottom plugged _____			
DRILLERS REMARKS:	DEPT. OF NATURAL RESOURCES BUREAU OF LAND & WATER RESOURCES OCT 12 1979 RECEIVED		

If well telescopes please sketch and show depths.

GROUND LEVEL

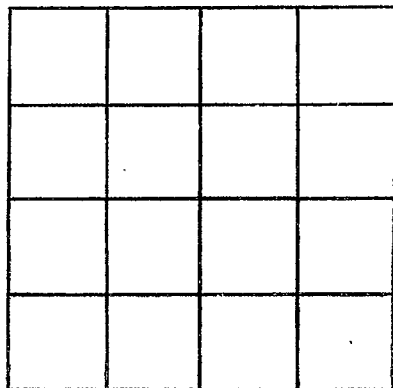

SECTION _____

Please indicate well location X.

ADDITIONAL INFORMATION

If more than one screen,
show locations of each on sketch.