

GW-00944

NEWTON
C-40
1-15-81

MISSISSIPPI
BOARD OF WATER COMMISSIONERS
416 North State Street
Jackson, Mississippi 39201

CODED

WATER WELL DRILLERS LOG

1-15 1981 Layne-Central Company Newton
date well completed firm name county well located

LANDOWNER:
Douglas-Hubbard Water Associates
Rt. 1, Little Rock, Miss.
(mailing address)

| description of formations encountered | from | to |
|---------------------------------------|------|-------|
| Red Clay | 0' | 15' |
| Sand & yellow clay | 15' | 70' |
| Hard clay | 70' | 145' |
| Sandy clay | 145' | 230' |
| Clay | 230' | 340' |
| Sandy shale | 340' | 490' |
| Shale | 490' | 670' |
| Sandy shale | 670' | 770' |
| Shale | 770' | 920' |
| Sand | 920' | 1026' |

WELL LOCATION: NE Qtr. of NW Qtr.
sec. 23 T. 8 N R. 12 E
-S -W
_____ miles of _____
(distance) (direction) (nearest town)

WELL PURPOSE:
(home, irrigation, municipal, industrial)

- WELL COMPLETION DATA:
- (1) diameter (inches) 10"
 - (2) total depth (feet) 1047'
 - (3) static water level (feet) 196' below top of ground.
 - (4) casing Steel, 986'
(material) (depth)
10" If telescope see back.
(size) 59' 9" or 6"
 - (5) screen 50', 986'
(length) (depth to top)
6", Stainless Steel
(size) (material)
 - (6) pump 30 200 GPM
(HP) (yield gpm)
Electric
(type power)
 - (7) electric log yes
(yes or no)
Layne-Central Co.
(organization running log)
 - (8) how well bottom plugged. Valve

DRILLERS REMARKS:


DEPT. OF NATURAL RESOURCES
BUREAU OF LAND & WATER RESOURCES

JAN 29 1981

RECEIVED

If well telescopes please sketch and show depths.

GROUND LEVEL

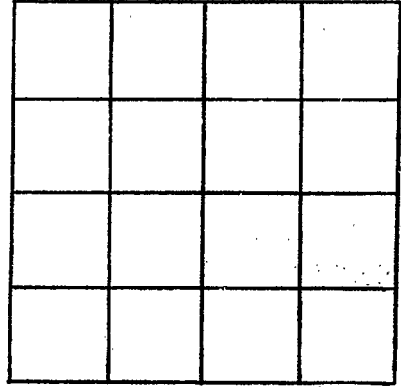

SECTION _____

Please indicate well location X.

ADDITIONAL INFORMATION

A series of horizontal lines providing space for additional information.

If more than one screen, show locations of each on sketch.