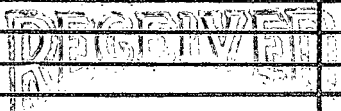


Newton  
 C 2000  
 12-8-75

MISSISSIPPI  
 BOARD OF WATER COMMISSIONERS  
 416 North State Street  
 Jackson, Mississippi 39201


WATER WELL DRILLERS LOG

12-8-75 19<sup>th</sup> McDonald & Well NEWTON  
 date well completed firm name county well located

LANDOWNER:	description of formations encountered	from	to
<u>Bobby Grisson</u>	<u>Clay</u>	0	32
<u>Rt 1 DECATUR</u> (mailing address)	<u>Sand</u>	32	45
<b>WELL LOCATION:</b> sec. <u>31</u> T. <u>8</u> N. R. <u>12</u> E <u>3</u> miles <u>North</u> of <u>DECATUR</u> (distance) (direction) (nearest town)	<u>Mud</u>	45	84
<b>WELL PURPOSE:</b> <u>WATER</u> (home, irrigation, municipal, industrial)	<u>Sand</u>	84	180
<b>WELL COMPLETION DATA:</b>	<u>Sandy</u>	180	192
(1) diameter (inches) <u>4"</u>	<u>Shale</u>	192	240
(2) total depth (feet) <u>315</u>	<u>Rock</u>	240	260
(3) static water level (feet) <u>140'</u> below top of ground.	<u>Sand &amp; Rock</u>	260	315
(4) casing <u>PVC</u> <u>232'</u> (material) (depth) <u>4"</u> If telescope, see back. (size)			
(5) screen _____ (length) (depth to top) (size) (material)			
(6) pump <u>1 sub 10</u> (HP) (yield gpm) <u>E</u> (type power)			
(7) electric log _____ (yes or no) (organization running log)			
(8) how well bottom plugged <u>OPEN</u>			
<b>DRILLERS REMARKS:</b> <u>SET PUMP 220</u>	 <u>DEC 29 1975</u>		

If well telescopes please sketch and show depths.

GROUND LEVEL

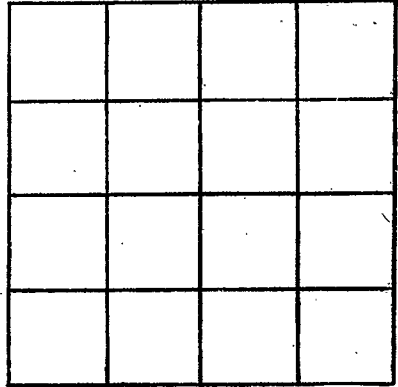

SECTION \_\_\_\_\_

Please indicate well location X.

ADDITIONAL INFORMATION

If more than one screen, show locations of each on sketch.