

**NEWTON**  
 C 2001  
 9-10-76

MISSISSIPPI  
 BOARD OF WATER COMMISSIONERS  
 416 North State Street  
 Jackson, Mississippi 39201

WATER WELL DRILLERS LOG

9. 10. 76  
 date well completed

13P

McDonald & Hill  
 firm name

Newton  
 county well located


LANDOWNER:	description of formations encountered	from	to
Ty Santymer			
Rt 2 Decatur (mailing address)	sandy sh rock	10	18
WELL LOCATION: sec. 16 T. 28 N. R. 12 E S W	sand	18	53
5 miles N. E. of Decatur (distance) (direction) (nearest town)	shale	53	83
WELL PURPOSE: (home, irrigation, municipal, industrial)	Rock & Shale	83	158
WELL COMPLETION DATA:	sandy	158	165
(1) diameter (inches) 4"	Sand & shale	165	180
(2) total depth (feet) 180'			
(3) static water level (feet) _____ below top of ground. above			
(4) casing PVC 70' (material) (depth)			
4" if telescope see back. (size)			
(5) screen _____ (length) (depth to top)			
(size) (material)			
(6) pump _____ (HP) (yield gpm)			
(type power)			
(7) electric log (yes or no) _____			
(organization running log)			
(8) how well bottom plugged open			
DRILLERS REMARKS:			

RECEIVED  
 SEP 15 1976

MISS. BD. OF WATER COMM.

If well telescopes please sketch and show depths.

GROUND LEVEL

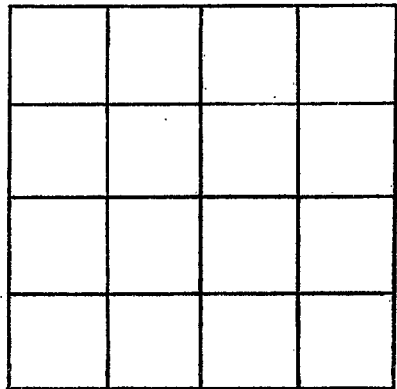

SECTION \_\_\_\_\_

Please indicate well location X.

ADDITIONAL INFORMATION

If more than one screen, show locations of each on sketch.