

MISSISSIPPI
BOARD OF WATER COMMISSIONERS
416 North State Street
13^P Jackson, Mississippi 39201

WATER WELL DRILLERS LOG

NEWTON
C 2004
7-22-77

7-22-77 19 McDonald & Hill Newton
date well completed firm name county well located

LANDOWNER:
M. J. Tourner
Rt #2 Decatur
(mailing address)

WELL LOCATION:
sec. 30 T 8 N R 12 E
S W
4 miles N of Decatur
(distance) (direction) (nearest town)

WELL PURPOSE: none
(home, irrigation, municipal, industrial)

WELL COMPLETION DATA:

- (1) diameter (inches) 4"
- (2) total depth (feet) 160'
- (3) static water level (feet) 95' below above top of ground.
- (4) casing PVC, 100'
(material) (depth)
4" if telescope see back.
(size)
- (5) screen —, —
(length) (depth to top)
—, —
(size) (material)
- (6) pump 1/2 600M
(HP) (yield gpm)
F
(type power)
- (7) electric log —
(yes or no)
—
(organization running log)
- (8) how well bottom plugged open

description of formations encountered	from	to
<u>sandy clay</u>	<u>0</u>	<u>10</u>
<u>sand</u>	<u>10</u>	<u>65</u>
<u>sandy shale</u>	<u>65</u>	<u>75</u>
<u>shale</u>	<u>75</u>	<u>105</u>
<u>RDs</u>	<u>105</u>	<u>125</u>
<u>green sand + sandy shale</u>	<u>125</u>	<u>140</u>
<u>RDs + shale + st sand</u>	<u>140</u>	<u>160</u>


DRILLERS REMARKS:

RECEIVED
AUG 1 1977

MISS. BD. OF WATER COMM

If well telescopes please sketch and show depths.

GROUND LEVEL

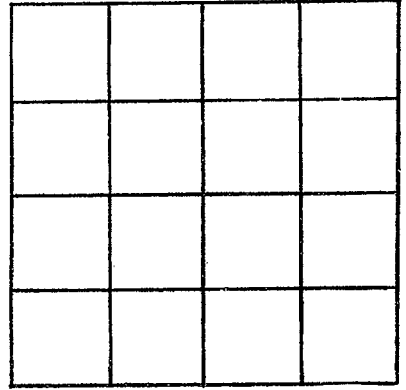

SECTION _____

Please indicate well location X.

ADDITIONAL INFORMATION

If more than one screen,
show locations of each on sketch.