

MISSISSIPPI DEPARTMENT OF NATURAL RESOURCES

Bureau of Land and Water Resources

Southport Mall

P.O. Box 10631

Jackson, Mississippi 39209

WATER WELL DRILLERS LOG

Newton
C
2007
5-7-82

date well completed

19

McDonald's Well

firm name

Newton

county well located

LANDOWNER:

Emmett Miley

Union

(mailing address)

description of formations encountered

Clay & sand

from

to

0 40

Sand

40 70

Shale

70 85

shale & rock

85 130

shale & sand

130 165

course sand

165 205

WELL LOCATION:

sec. 5 T. 8 N. R. 12 E. S. 1 W. 1/2 miles E of Union (distance) (direction) (nearest town)

WELL PURPOSE: home (home, irrigation, municipal, industrial)

WELL COMPLETION DATA:

- (1) diameter (inches) 4"
- (2) total depth (feet) 205
- (3) static water level (feet) 140 below above top of ground.
- (4) casing PVC, 195' (material) (depth) 4" (size) if telescope see back.
- (5) screen 10', 195 to 205' (length) (depth to top) 4" (size) PVC (material)
- (6) pump 1/2, 35 gpm (HP) (yield gpm) E (type power)
- (7) electric log — (yes or no) (organization running log)
- (8) how well bottom plugged unplugged

DEPT. OF NATURAL RESOURCES  
BUREAU OF LAND & WATER RESOURCES


JUN 22 1982

RECEIVED

DRILLERS REMARKS:

If well telescopes please sketch and show depths.

GROUND LEVEL

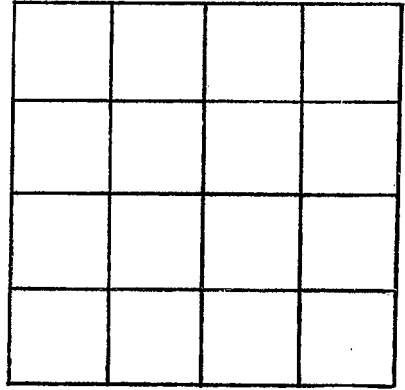

SECTION \_\_\_\_\_

Please indicate well location X.

ADDITIONAL INFORMATION

If more than one screen, show locations of each on sketch.