

MISSISSIPPI DEPARTMENT OF NATURAL RESOURCES
Bureau of Land and Water Resources
Southport Mall
P.O. Box 10631
Jackson, Mississippi 39209
WATER WELL DRILLERS LOG

<u>Newton</u>
<u>C</u>
<u>2008</u>

8-2-82 19 McDonald's Well Newton
date well completed firm name county well located

LANDOWNER:
Mrs. Annie Cleveland
RT #2 Union
(mailing address)

WELL LOCATION:
sec. 30 T. 8 N. R. 12 E. S. 3 W.
3 miles N of Decatur
(distance) (direction) (nearest town)

WELL PURPOSE: home
(home, irrigation, municipal, industrial)

WELL COMPLETION DATA:

(1) diameter (inches) 4"

(2) total depth (feet) 180'

(3) static water level (feet) 100' below above top of ground.

(4) casing PVC, 100' (material) (depth)
4" (size) if telescope see back.

(5) screen _____ (length) _____ (depth to top)

(size) (material)

(6) pump 1/2, 800 gpm. (HP) (yield gpm)
K (type power)

(7) electric log _____ (yes or no)
_____ (organization running log)

(8) how well bottom plugged open

description of formations encountered	from	to
	<u>clay</u>	<u>0</u>
<u>sand & clay</u>	<u>10</u>	<u>70</u>
<u>sandy shale</u>	<u>70</u>	<u>80</u>
<u>shale</u>	<u>80</u>	<u>107</u>
<u>rock shells</u>	<u>107</u>	<u>125</u>
<u>green sand</u>	<u>125</u>	<u>135</u>
<u>sand of rocks & shells</u>	<u>135</u>	<u>180</u>

DEPT. OF NATURAL RESOURCES
BUREAU OF LAND & WATER RESOURCES


AUG 9 1982

RECEIVED

DRILLERS REMARKS:

If well telescopes please
sketch and show depths.

GROUND LEVEL

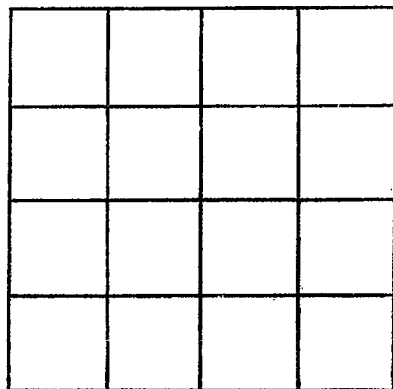

SECTION _____

Please indicate well location X.

ADDITIONAL INFORMATION

If more than one screen,
show locations of each on sketch.