

MISSISSIPPI DEPARTMENT OF NATURAL RESOURCES
Bureau of Land and Water Resources
 Southport Mall
 P.O. Box 10631
 Jackson, Mississippi 39209
WATER WELL DRILLERS LOG

Newton
C
2009

1-1 1985 McDonald & Hill Inc Newton
 date well completed firm name county well located

LANDOWNER: Orance Ethridge
Rt # 4 Box 253
Union, MS
 (mailing address)

| description of formations encountered | from | to |
|---------------------------------------|------------|------------|
| <u>Clay + sand</u> | <u>0</u> | <u>60</u> |
| <u>Shale st sands</u> | <u>60</u> | <u>85</u> |
| <u>Rock + shale</u> | <u>85</u> | <u>160</u> |
| <u>st sand</u> | <u>160</u> | <u>185</u> |
| <u>coarse sand</u> | <u>185</u> | <u>202</u> |

WELL LOCATION:
 sec. 4 T. 8 N. R. 12 E
S
 (distance) miles (direction) of (nearest town)

WELL PURPOSE: None
 (home, irrigation, municipal, industrial)

- WELL COMPLETION DATA:
- (1) diameter (inches) 4
 - (2) total depth (feet) 202'
 - (3) static water level (feet) 158' below top of ground.
 - (4) casing 4" PVC (material) 192' (depth)
 - (size) If telescope see back.
 - (5) screen 10' (length) (depth to top)
 - 4" (size) #12 (material)
 - (6) pump (HP) 15 (yield gpm)
 - (type power)
 - (7) electric log (yes or no)
 - (organization running log)
 - (8) how well bottom plugged


RECEIVED
 JAN 31 1985

Department of Natural Resources
 Bureau of Land & Water Resources

DRILLERS REMARKS:

If well telescopes please
sketch and show depths.

GROUND LEVEL

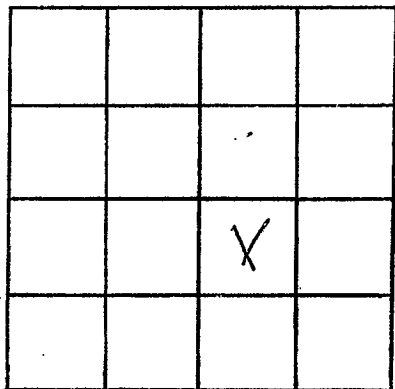

SECTION K

Please indicate well location X.

ADDITIONAL INFORMATION

If more than one screen,
show locations of each on sketch.