

MISSISSIPPI DEPARTMENT OF ENVIRONMENTAL QUALITY
Bureau of Land and Water Resources

P. O. Box 10631
Jackson, MS 39289-0631
WATER WELL DRILLERS LOG

COUNTY WELL LOCATED NEWTON	
WELL NUMBER #1	CODED
C 2014	
DATE WELL COMPLETED 2-21-95	

PERMIT NUMBER
NAME OF DRILLING FIRM GARDNER DRILLING
SEBRING, MS.

NAME & MAILING ADDRESS OF LANDOWNER DALE YATES		
RT. 4 Box 154		
UNION, MS. 39365		
WELL LOCATION: SEC	TOWNSHIP	RANGE
9	8	N 12 E
DISTANCE	DIRECTION	NEAREST TOWN
3 Miles	E	UNION
OTHER LANDMARK		
WELL PURPOSE: Home, Irrigation, Municipal, Industrial, Fish Pond, etc. POULTRY FARM		

PUMP DATA		
PUMP TYPE (Circle One): Submersible Turbine, Jet, Flowing Well, Other (Describe) _____		
POWER TYPE (Circle One): Electric Tractor, Diesel, Gasoline, Butane, Other (Describe) _____ H/P 1		
Pump Capacity (GPM)	No. of Stages	Setting Depth
10	12	100' FT.
PUMP TEST		
Well yielded 12 GPM with a drawdown of 50 ft. after 1 hours of pumping		

WELL DATA		
Well Depth 100	Casing Diameter (In.) 4	Casing Length (Ft.) 180
Type of Casing PVC	Hole Depth 100	Depth to Static Water Level 60
TYPE OF COMPLETION: (Circle One or More): Gravel Packed, Underreamed, Telescoped, Natural Development , Open Hole, Other (Describe) _____		
Top of Lap Pipe or Reduction in Casing FEET IF TELESCOPED OR MORE THAN ONE SCREEN: USE BACK PAGE		

LOG DATA	
TYPE OF LOG RUN (Circle One): No Log Run, Electric, Gamma Ray, Density, Sonic, Neutron, Other (Describe) _____	
Name of Organization Running Log	

SCREEN DATA		
Diameter - Inches 4	Length - Feet 10	Slot Size - Inches 8
Screen Type PVC		Depth to Bottom - Feet 180


GEOLOGIC DATA (Office Use Only)			
Surface Elev.	Geologic Unit	Unit Thickness	Depth to Top
Subs. SWL	Date	Analysis	Aquifer Test
Driller's Remarks			

DESCRIPTION OF FORMATIONS ENCOUNTERED	FROM	TO
clay	0	20
sand	20	180'

FORMATIONS (Continued)	FROM	TO
RECEIVED		
AUG 16 1995		
Dept. of Environmental Quality Office of Land & Water Resources		
IF MORE SPACE IS NEEDED, USE BACK		

If well telescopes please
sketch and show depths.

GROUND LEVEL

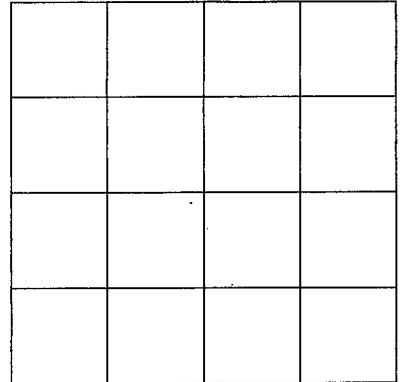

SECTION _____

Please indicate well location X.

ADDITIONAL INFORMATION

If more than one screen,
show location of each on sketch.