

D14
8-7-62

WATER WELL DRILLERS LOG

J. Loman
J. Loman

Date: 8-7, 1962, Driller: J. Loman County: Newton

(Name)

(1) Owner of Land: Mrs. Mary Williams
(Name)
Little Rock Miss
(Address)

(2) Location: 1/4, 1/4, Sec. 19 T 8 R 13
1/4 miles E of Little Rock
(distance) (direction) (Nearest Town)

(3) Topography: X
(Hilly) (Flat) (Level)

(4) Purpose of Well: Domestic
(Domestic Irrigation
Municipal, Industrial, Other)


Description & Color of Materials. Sand, Clay, Red Clay, Shell, etc.	Thick- ness Feet	Depth Feet
<u>0-36 Clay</u>	<u>0</u>	<u>30</u>
<u>30-50 Sand</u>	<u>30</u>	<u>60</u>
<u>50-65 Sand & Clay</u>	<u>15</u>	<u>75</u>
<u>65-85 Blue Clay</u>	<u>20</u>	<u>95</u>
<u>85-110 Sand</u>	<u>25</u>	<u>120</u>
<u>110-115 Gray Sand</u>	<u>5</u>	<u>125</u>

Information upon completion of well:

- (1) Diameter 2 inches.
- (2) Total Depth 175 feet.
- (3) Water Level 49 feet below top of ground.
- (4) Cased to 80, Size 2
- (5) Screen: Size _____, Length _____
- (6) Were any formations sealed against pollution?
_____ yes, _____ no.

If YES depth of formation _____
Why _____

Drillers Remarks: Open Well
No Screen

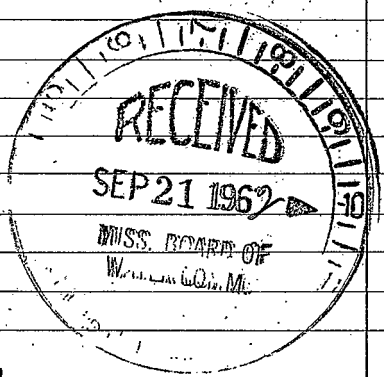

(Use Back Side)

Well No.

