

D 15

9-26-64

WATER WELL DRILLERS LOG

Date: 9-26, 19 64, Driller: Bob Williams, County Newton  
(Name)

(1) Owner of Land: Sony Dean  
(Name)  
Duffee, Miss.  
(Address)

(2) Location: 1/4, 1/4, Sec. 36 T. 8 R. 13, N E  
15 miles West, of Merida  
(distance) (direction) (Nearest Town)

(3) Topography: hilly  
(Hilly) (Flat) (Level)

(4) Purpose of Well: domestic  
(Domestic Irrigation  
Municipal, Industrial, Other)

Description & Color of Materials Sand, Clay, Red Clay, Shell, etc.	Thick- ness Feet	Depth Feet
Red clay	20	1-20
Rock	75	20-95
Blue Clay	15	95-160
fine gray sand	73	160-233

Information upon completion of well:

(1) Diameter 2 inches.

(2) Total Depth 233 feet.

(3) Water Level 120 feet below top of ground.

(4) Cased to 147, Size 2"

(5) Screen: Size 0, Length


(6) Were any formations sealed against pollution?

Yes, no.

If YES depth of formation

Why surface water

Drillers Remarks:

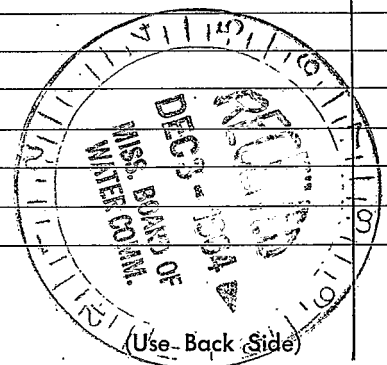

Well No.

