

3 NEWTON  
D16

MISSISSIPPI BOARD OF WATER COMMISSIONERS

WATER WELL DRILLERS LOG

10-24-64

Date: 10-24, 1964, Driller: Bob Williams County Newton  
(Name)

(1) Owner of Land: Elbert Cleama  
(Name)  
Duffee, Mess  
(Address)

(2) Location: SW 1/4, SE 1/4, Sec. 26 T. 8 N. R. 13  
1.5 miles West, of Meridian  
(distance) (direction) (Nearest Town)

(3) Topography: hilly  
(Hilly) (Flat) (Level)

(4) Purpose of Well: Domestic  
(Domestic Irrigation  
Municipal, Industrial, Other)

Description & Color of Materials Sand, Clay, Red Clay, Shell, etc.	Thick- ness Feet	Depth Feet
<u>Red clay</u>	<u>10</u>	<u>1-10</u>
<u>Rock</u>	<u>75</u>	<u>10-85</u>
<u>Blue clay</u>	<u>65</u>	<u>85-150</u>
<u>fine gray sand</u>	<u>83</u>	<u>150-233</u>

Information upon completion of well:

(1) Diameter 2 inches.

(2) Total Depth 233 feet.

(3) Water Level 140 feet below top of ground.

(4) Cased to 147, Size 2"


(5) Screen: Size 0, Length \_\_\_\_\_

(6) Were any formations sealed against pollution?  
 yes, \_\_\_\_\_ no.

If YES depth of formation \_\_\_\_\_

Why surface water

Drillers Remarks: \_\_\_\_\_

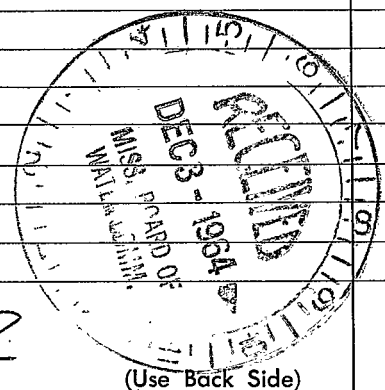

2

Well No.

(Use Back Side)

