

Newton
D 19
11-11-68

MISSISSIPPI
 BOARD OF WATER COMMISSIONERS
 416 North State Street
 Jackson, Mississippi 39201

CODED

WATER WELL DRILLERS LOG

11-11-
 date well completed

1968 Williams Drilling Co
 firm name

Newton
 county well located

LANDOWNER: W. J. Brett
At Collinsville, Miss.
 (mailing address)

description of formations encountered	from	to
	<u>Blue Clay</u>	<u>0</u>
<u>Gray sand</u>	<u>35</u>	<u>47</u>

WELL LOCATION:
 sec. 1 T. 8 (N) R. 13 (E)
1.8 miles N.W. of Newton
 (distance) (direction) (nearest town)

WELL PURPOSE: Home
 (home, irrigation, municipal, industrial)

- WELL COMPLETION DATA:
- (1) diameter (inches) 2
 - (2) total depth (feet) 47
 - (3) static water level (feet) 20 (below top of ground)
 - (4) casing Pvc. 42
(material) (depth)
2 if telescope see back.
(size)
 - (5) screen 5 42
(length) (depth to top)
12 strainers
(size) (material)
 - (6) pump 1/2 5
(HP) (yield gpm)
Elect.
(type power)
 - (7) electric log No
(yes or no)
No
(organization running log)
 - (8) how well bottom plugged Cap.

CODED


NOV 28 1968

MISS. BD. OF
 19

DRILLERS REMARKS:

If well telescopes please sketch and show depths.

GROUND LEVEL

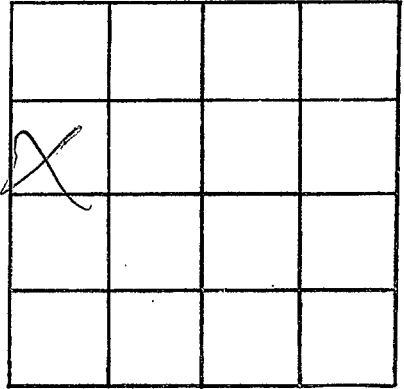

SECTION 1

Please indicate well location X.

ADDITIONAL INFORMATION

If more than one screen,
show locations of each on sketch.