

NEWTON

D 21

10-31-69

MISSISSIPPI BOARD OF WATER COMMISSIONERS
416 North State Street
Jackson, Mississippi 39201

CODED

WATER WELL DRILLERS LOG

10-31

1969 McDonald Hill Inc

Newton

date well completed

firm name

county well located

LANDOWNER: Joseph Gutman

Pl. 120650

Collinsville Miss

(mailing address)

WELL LOCATION:

sec. 1 T 8 N R 13 E
S W
9 miles North of Collinsville
(distance) (direction) (nearest town)

WELL PURPOSE: home
(home, irrigation, municipal, industrial)

WELL COMPLETION DATA:

- (1) diameter (inches) 4
- (2) total depth (feet) 200
- (3) static water level (feet) 60 below top of ground.
- (4) casing 4" black, 126,
(material) (depth)
no if telescope see back.
(size)
- (5) screen no,
(length) (depth to top)
(size) (material)
- (6) pump 1/2 10
(HP) (yield gpm)
meter submersible
(type power)
- (7) electric log no
(yes or no)
no
(organization running log)
- (8) how well bottom plugged
open end

description of formations encountered

from to

clay	0	15
shell	15	82
sandy shell	82	90
shell	90	110
st fine sand	110	126
shell	126	140
fine sand	140	156
sandy	156	180
st coarse sand	180	200


DRILLERS REMARKS: none

NOV 12 1969

MISS. BD. OF WATER COMMISSIONERS

If well telescopes please sketch and show depths.

GROUND LEVEL

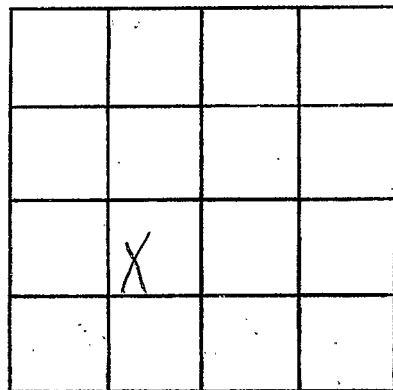

SECTION 1

Please indicate well location X.

ADDITIONAL INFORMATION

If more than one screen, show locations of each on sketch.