

Newton
D 23
6-11-70

MISSISSIPPI
 BOARD OF WATER COMMISSIONERS
 416 North State Street
 Jackson, Mississippi 39201

CODED

WATER WELL DRILLERS LOG

6-11- 1970 Williamson, Dillingham Newton
 date well completed firm name county well located

LANDOWNER: Allen Harrington
Collinsville, Miss.
 (mailing address)

description of formations encountered	from	to
<u>top soil</u>	<u>0</u>	<u>3</u>
<u>Blue Clay</u>	<u>3</u>	<u>15</u>
<u>sand</u>	<u>15</u>	<u>23</u>
<u>Blue Clay</u>	<u>23</u>	<u>37</u>
<u>sand</u>	<u>37</u>	<u>51</u>

WELL LOCATION:
 sec 2 T 8 S R 13 E
4 miles n.w. of Collinsville
 (distance) (direction) (nearest town)

WELL PURPOSE: farm
 (home, irrigation, municipal, industrial)

- WELL COMPLETION DATA:
- (1) diameter (inches) 2
 - (2) total depth (feet) 51
 - (3) static water level (feet) 20 (below/above top of ground)
 - (4) casing galv. (material), 46 (depth)
2 (size) if telescope see back.
 - (5) screen 5 (length), 46 (depth to top)
12 (size), plastic (material)
 - (6) pump 1/2 (HP), 6 (yield gpm)
Elect. (type power)
 - (7) electric log no (yes or no)
no (organization running log)
 - (8) how well bottom plugged Cap.

CODED


JUL 14 1970

DRILLERS REMARKS:

MISS. BD. OF
 WATER COMM.

If well telescopes please sketch and show depths.

GROUND LEVEL

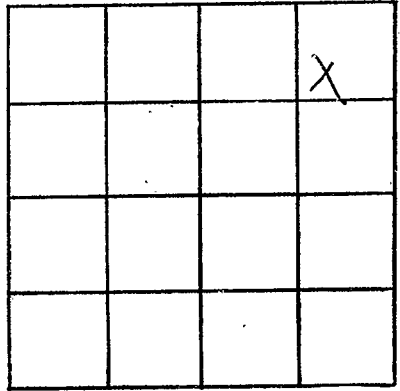

SECTION 2

Please indicate well location X.

ADDITIONAL INFORMATION

If more than one screen, show locations of each on sketch.