

NEWTON

MISSISSIPPI BOARD OF WATER COMMISSIONERS  
416 North State Street  
Jackson, Mississippi 39201

**CODED**

WATER WELL DRILLERS LOG

~~NEWTON~~  
D 24  
11-5-70

11-5-  
date well completed

1970 R B Nicholson  
firm name

Neshoba  
county well located

LANDOWNER: James Beckham

description of formations encountered

from

to

Union

Chalk

0 15

Miss.

blue dirt

15 150

(mailing address)

rock

150 157

WELL LOCATION:

blue dirt

152 215

sec 30 T-80 N 7 R 13 E OK

Water Sand

215 250

0.9 miles SE of Union  
(distance) (direction) (nearest town)

WELL PURPOSE: home  
(home, irrigation, municipal, industrial)

WELL COMPLETION DATA:

(1) diameter (inches) 4 1/4

(2) total depth (feet) 250

(3) static water level (feet) 25 below above top of ground.

(4) casing Galv 126  
(material) (depth)

**CODED**

X If telescope see back.  
(size)

(5) screen X X  
(length) (depth to top)

X X  
(size) (material)

(6) pump 1 15  
(HP) (yield gpm)

Elect  
(type power)

(7) electric log  
(yes or no)

(organization running log)

(8) how well bottom plugged open


DEC 15 1970

MISS. BD. OF  
WATER COMM.

DRILLERS REMARKS:

If well telescopes please sketch and show depths.

GROUND LEVEL

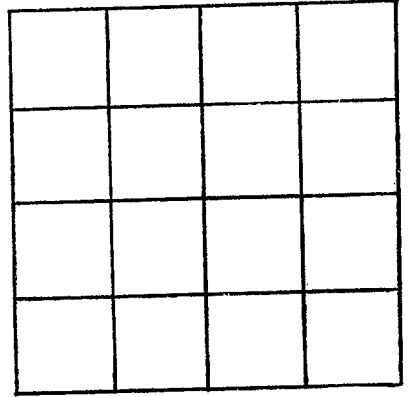

SECTION \_\_\_\_\_

Please indicate well location X.

ADDITIONAL INFORMATION

If more than one screen, show locations of each on sketch.