

NEWTON
D 25
2-17-71

MISSISSIPPI
BOARD OF WATER COMMISSIONERS
416 North State Street
Jackson, Mississippi 39201

CODED

WATER WELL DRILLERS LOG

2-15-1971 date well completed
Williamson Drilling Co firm name
Newton county well located

LANDOWNER	description of formations encountered	from	to
James H. Henssett	top soil	0	2
Collierville, Miss. (mailing address)	red clay	2	8
	red sand	8	24
	blue clay	24	60
	sand	60	110
	split red sand + clay	110	138
	blue clay	138	150
	sand	150	220

WELL LOCATION:
sec. 24 T 80 N R 13 E S
3 miles West of Collierville
(distance) (direction) (nearest town)

WELL PURPOSE: Home
(home, irrigation, municipal, industrial)

WELL COMPLETION DATA:

(1) diameter (inches) 4

(2) total depth (feet) 220

(3) static water level (feet) 53 ^{below} top of ground.

(4) casing: 1 1/4" (material) 144' (depth)

1/2" (size) if telescope see back.

(5) screen: no (length) (depth to top)

(size) (material)

(6) pump: 1/2 (HP) 9 (yield gpm)

Electric (type power)

(7) electric log: no (yes or no)

no (organization running log)

(8) how well bottom plugged: open

DRILLERS REMARKS:


CODED

MAR 30 1971

MISS. BD. OF
WATER COMMISSIONERS

If well telescopes please sketch and show depths.

GROUND LEVEL

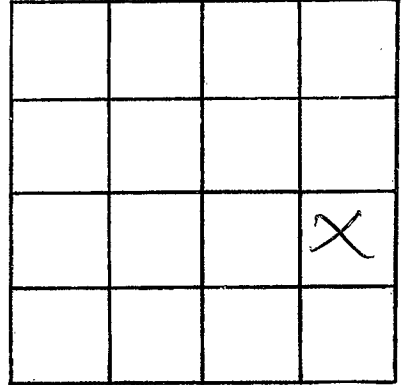

SECTION 24

Please indicate well location X.

ADDITIONAL INFORMATION

If more than one screen, show locations of each on sketch.