

NEWTON

D26

6-17-71

MISSISSIPPI BOARD OF WATER COMMISSIONERS
416 North State Street
Jackson, Mississippi 39201

CODED

WATER WELL DRILLERS LOG

6-17
date well completed

1971 B B Nicholson
firm name

Newton
county well located

LANDOWNER: J T Chesney

description of formations encountered

from to

Little Rock

Clay

0 19

Miss -

mix clay & chert 19 60

(mailing address)

blue dirt 60 135

WELL LOCATION:

sec. 23 T 8 N R 13 E
12 miles South of Union
(distance) (direction) (nearest town)

Shell & rock 135 147

mix sand & dirt 143 180

water sand 180 194

WELL PURPOSE: home
(home, irrigation, municipal, industrial)

WELL COMPLETION DATA:

- (1) diameter (inches) 4 1/4"
- (2) total depth (feet) 194'
- (3) static water level (feet) 110' below top of ground.
- (4) casing gal. 189'
(material) (depth)
2" If telescope see back.
(size)
- (5) screen 5" 194'
(length) (depth to top)
1/4" Steel
(size) (material)
- (6) pump 1/2 4
(HP) (yield gpm)
Elect
(type power)
- (7) electric log no
(yes or no)

CODED

(organization running log)


(8) how well bottom plugged

DRILLERS REMARKS:

NOV 12 1971

If well telescopes please sketch and show depths.

GROUND LEVEL

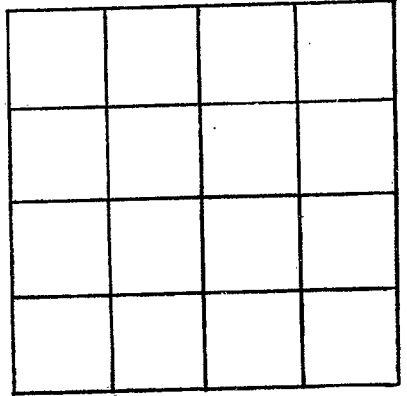

SECTION _____

Please indicate well location X.

ADDITIONAL INFORMATION

If more than one screen, show locations of each on sketch.