

Newton
D 28
519

MISSISSIPPI
 BOARD OF WATER COMMISSIONERS
 416 North State Street
 Jackson, Mississippi 39201

CODED

WATER WELL DRILLERS LOG

May 19 79 Robert & Ruffin Co, Inc. Newton
 date well completed firm name county well located

LANDOWNER:	description of formations encountered	from	to
<u>Ruffin W. G.</u>			
<u>#2 well</u> (mailing address)	<u>Sand</u>	<u>20</u>	<u>60</u>
WELL LOCATION:	<u>clay</u>	<u>60</u>	<u>70</u>
sec <u>25</u> T <u>8</u> N R <u>13</u> E	<u>Sand</u>	<u>70</u>	<u>110</u>
<u>1</u> N OR <u>DELF</u> <u>9</u> W	<u>Clay</u>	<u>110</u>	<u>390</u>
<u>1/2</u> miles <u>West</u> of <u>Newton</u>	<u>Shale</u>	<u>390</u>	<u>460</u>
(distance) (direction) (nearest town)	<u>Clay</u>	<u>460</u>	<u>530</u>
WELL PURPOSE:	<u>Sand</u>	<u>530</u>	<u>540</u>
(home, irrigation, municipal, industrial)	<u>Clay</u>	<u>540</u>	<u>725</u>
WELL COMPLETION DATA:	<u>Sand</u>	<u>725</u>	<u>740</u>
(1) diameter (inches) <u>8 x 4</u>	<u>Clay</u>	<u>740</u>	<u>800</u>
(2) total depth (feet) <u>885</u>	<u>Sand</u>	<u>800</u>	<u>990</u>
(3) static water level (feet) <u>110'</u> below above top of ground.	<u>Clay</u>	<u>990</u>	<u>995</u>
(4) casing <u>steel</u> , <u>804</u> , (material) (depth) <u>8"</u> (size) If telescope see back.			
(5) screen <u>40'</u> , <u>120'</u> (length) (depth to top) <u>4"</u> , <u>SS Screen</u> (size) (material)			
(6) pump <u>15</u> <u>150</u> (HP) (yield gpm) <u>electric</u> (type power)			
(7) electric log <u>Yes</u> (yes or no) <u>State</u> (organization running log)			
(8) how well bottom plugged <u>BPT</u>			
DRILLERS REMARKS:			

D grid placed on log out so job

CODED


DEPT. OF NATURAL RESOURCES
 BUREAU OF LAND & WATER RESOURCES

MAR 24 1980

RECEIVED

If well telescopes please sketch and show depths.

GROUND LEVEL

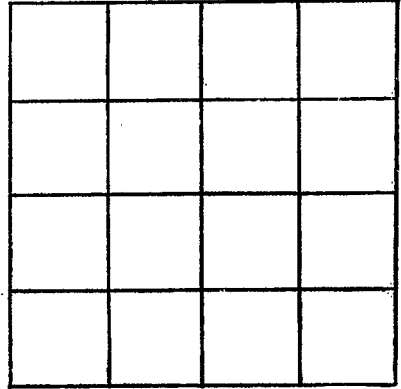

SECTION _____

Please indicate well location X.

ADDITIONAL INFORMATION

If more than one screen, show locations of each on sketch.