

NEWTON
D 2000.
4-9-77

MISSISSIPPI
 BOARD OF WATER COMMISSIONERS
 416 North State Street
 Jackson, Mississippi 39201

WATER WELL DRILLERS LOG

13P

4-9-77 19 McDonald & Hill Newton
 date well completed firm name county well located


LANDOWNER:	description of formations encountered	from	to
<u>Lombard Crocker</u>	<u>clay</u>	<u>0</u>	<u>15</u>
<u>Rt # 9 Union</u> (mailing address)	<u>st rock + sand</u>	<u>15</u>	<u>40</u>
<u>WELL LOCATION:</u>	<u>sand</u>	<u>40</u>	<u>85</u>
sec <u>5</u> T. <u>10 N</u> R. <u>15 W</u>	<u>shale st Rock</u>	<u>85</u>	<u>175</u>
<u>6</u> miles <u>F</u> of <u>Union</u> (distance) (direction) (nearest town)	<u>sand st shale</u>	<u>175</u>	<u>195</u>
<u>WELL PURPOSE:</u> <u>home</u> (home, irrigation, municipal, industrial)	<u>course sand</u>	<u>195</u>	<u>230</u>
<u>WELL COMPLETION DATA:</u>	<u>fine sand + shale</u>	<u>230</u>	<u>265</u>
(1) diameter (inches) <u>4"</u>	<u>shale</u>	<u>265</u>	<u>275</u>
(2) total depth (feet) <u>420'</u>	<u>shale + lignite</u>	<u>275</u>	<u>290</u>
(3) static water level (feet) <u>142</u> below top of ground.	<u>shale</u>	<u>290</u>	<u>385</u>
(4) casing <u>PVC</u> , <u>290'</u> (material) (depth)	<u>sand + shale</u>	<u>385</u>	<u>420</u>
<u>4"</u> if telescope see back. (size)			
(5) screen <u>10'</u> , <u>410 to 420</u> (length) (depth to top)			
<u>2"</u> , <u>PVC</u> (size) (material)			
(6) pump <u>3/4</u> <u>600 gpm</u> (HP) (yield gpm)			
<u>F</u> (type power)			
(7) electric log <u>—</u> (yes or no)			
(organization running log)			
(8) how well bottom plugged <u>valve</u>			
<u>DRILLERS REMARKS:</u>			

RECEIVED

APR 18 1977

If well telescopes please
sketch and show depths.

GROUND LEVEL

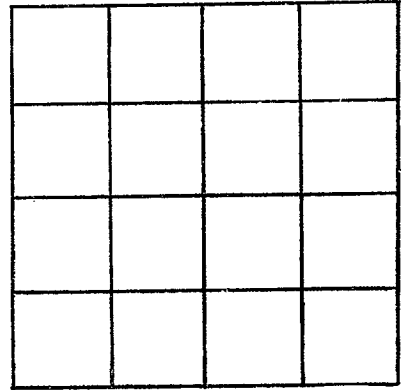

SECTION _____

Please indicate well location X.

ADDITIONAL INFORMATION

If more than one screen,
show locations of each on sketch.