

Newton  
D 2004

MISSISSIPPI  
BOARD OF WATER COMMISSIONERS  
416 North State Street  
Jackson, Mississippi 39201

WATER WELL DRILLERS LOG

Oct. 5 1986  
date well completed

HAROLD POOLE  
firm name


NEWTON  
county well located

LANDOWNER: <u>WAYNE MERRELL</u>	description of formations encountered	from	to
<u>RT 1</u>	<u>RED &amp; WHITE CLAY</u>		
<u>COLLINSVILLE, MISS. 39325</u> (mailing address)	<u>MIXED</u>	<u>0'</u>	<u>5'</u>
WELL LOCATION: sec. <u>11</u> T <u>8</u> N R <u>13</u> E S W	<u>BLUE SHELL</u>	<u>5'</u>	<u>44'</u>
<u>6</u> miles <u>NW</u> of <u>COLLINSVILLE</u> (distance) (direction) (nearest town)	<u>FINE SAND - DARK</u>	<u>44'</u>	<u>46'</u>
WELL PURPOSE: <u>HOUSE TRAILER</u> (home, irrigation, municipal, industrial)	<u>BLUE SHELL</u>	<u>55'</u>	<u>66'</u>
WELL COMPLETION DATA:	<u>GREEN SHELL OR MUD</u>		
(1) diameter (inches) <u>2"</u>	<u>MUD</u>	<u>66'</u>	<u>78'</u>
(2) total depth (feet) <u>231</u>	<u>HARD SHELL</u>	<u>78'</u>	<u>92'</u>
(3) static water level (feet) <u>60</u> below top of ground.	<u>TRACES of LIGNITE</u>	<u>92'</u>	<u>100'</u>
(4) <u>5 1/2" 40 PVC</u> casing (material) <u>140'</u> (depth)	<u>SHELL</u>	<u>100'</u>	<u>105'</u>
_____ (size) if telescope see back.	<u>THIN ROCK</u>	<u>105'</u>	<u>105 1/2'</u>
(5) screen <u>SHELL TRAP</u> <u>120'</u> (length) (depth to top)	<u>ABOUT 4" thick</u>		
_____ (size) _____ (material)	<u>HARD SHELL</u>	<u>105 1/2'</u>	<u>165'</u>
(6) pump <u>1</u> (HP) <u>6</u> (yield gpm)	<u>LAYER SAND</u>	<u>165'</u>	<u>172'</u>
<u>220 Electric</u> (type power)	<u>HARD SHELL</u>	<u>172'</u>	<u>198'</u>
(7) electric log _____ (yes or no)	<u>NOV 7 1986</u>		
_____ (organization running log)			
(8) how well bottom plugged <u>OPEN</u>			
DRILLERS REMARKS: <u>Seem to be good fairly soft water</u>			

Department of Natural Resources  
Bureau of Land & Water Resources

If well telescopes please sketch and show depths.

GROUND LEVEL

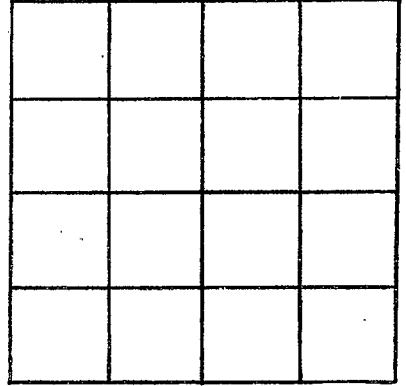

SECTION \_\_\_\_\_

Please indicate well location X.

ADDITIONAL INFORMATION

If more than one screen,  
show locations of each on sketch.