

E 6  
2-16-62

WATER WELL DRILLERS LOG

Date: 2-16, 1962, Driller: R R Nicholas, County: Newton  
(Name)

(1) Owner of Land: C. W. Madden  
(Name)  
Union Mills #4  
(Address)

(2) Location: 1/4, 1/4, Sec. 16 T<sup>1N</sup> R<sup>10E</sup>  
13 miles S - West, of Union  
(distance) (direction) (Nearest Town)

(3) Topography: X  
(Hilly) (Flat) (Level)

(4) Purpose of Well: Domestic  
(Domestic Irrigation  
Municipal, Industrial, Other)


Description & Color of Materials Sand, Clay, Red Clay, Shell, etc.	Thick- ness Feet	Depth Feet
Sand & Chalk	1	30
blue & sand	30	60
brown sand	60	100
Mix ground & sand	100	110
Water sand	110	120

Information upon completion of well:

- (1) Diameter 4 1/2 inches.
- (2) Total Depth 120 feet.
- (3) Water Level 50 feet below top of ground.
- (4) Cased to Joint, Size 2'
- (5) Screen: Size 1 1/2, Length 6 ft.
- (6) Were any formations sealed against pollution?  
yes, no no.

If YES depth of formation \_\_\_\_\_  
Why \_\_\_\_\_

Drillers Remarks: this well has 35 ft case brown sand no good for water

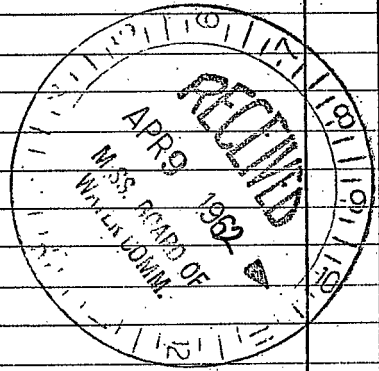

(Use Back Side)

Well No.

MEMORANDUM FOR THE DIRECTOR

DATE: 10/15/54

TO: SAC, NEW YORK (100-100000)

FROM: SAC, NEW YORK (100-100000)

SUBJECT: [Illegible]

[Illegible]

[Illegible]

