

JEI2
8-5-62

WATER WELL DRILLERS LOG

Date: 8-5, 1962, Driller: LEACH County: NEWTON

(Name)

- (1) Owner of Land: DODD, DENNIS
(Name)
LAKE MISS
(Address)
- (2) Location: 1/4, 1/4, Sec. 33 T1N1E
5 miles NE of LAKE
(distance) (direction) (Nearest Town)
- (3) Topography: HILLY
(Hilly) (Flat) (Level)
- (4) Purpose of Well: DOMESTIC
(Domestic Irrigation, Municipal, Industrial, Other)


Description & Color of Materials Sand, Clay, Red Clay, Shell, etc.	Thick- ness Feet	Depth Feet
RED CLAY	28	
BLUE CLAY	20	40
BROWN CLAY	30	70
SAND	40	110

Information upon completion of well:

- (1) Diameter 2 inches.
- (2) Total Depth 110 feet.
- (3) Water Level 65 feet below top of ground.
- (4) Cased to 110, Size 2"
- (5) Screen: Size 2", Length 6'
- (6) Were any formations sealed against pollution?
no

If YES depth of formation _____
Why _____

Drillers Remarks: _____

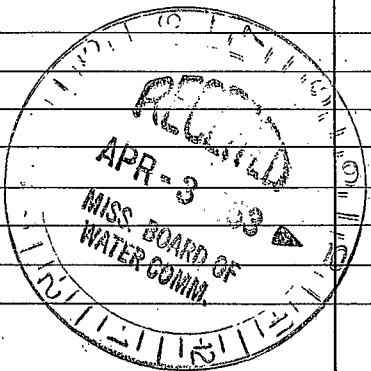

(Use Back Side)

Well No. _____

[The page contains extremely faint and illegible text, likely bleed-through from the reverse side of the document. No specific words or phrases can be discerned.]