

Newton
E 19
1-25-68

MISSISSIPPI
BOARD OF WATER COMMISSIONERS
416 North State Street
Jackson, Mississippi 39201

CODED

WATER WELL DRILLERS LOG

1-25-68 date well completed 1968 firm name *Common Drilling Co Newton* county well located

LANDOWNER: *Coyt Leach*
Ammon Lot 2
Ammon
(mailing address)

description of formations encountered	from	to
<i>Clay & sand</i>	<i>0</i>	<i>60</i>
<i>Clay Blue</i>	<i>60</i>	<i>83</i>
<i>Sand</i>	<i>83</i>	<i>99</i>

WELL LOCATION:
sec. 1 T. 7 N. R. 10 E.
S. W.
3 miles E of Conibath
(distance) (direction) (nearest town)

WELL PURPOSE: *Home*
(home, irrigation, municipal, industrial)

- WELL COMPLETION DATA:
- (1) diameter (inches) 5"
 - (2) total depth (feet) 99
 - (3) static water level (feet) 75 below above top of ground.
 - (4) casing 5' at 94'
(material) (depth)
 if telescope see back.
(size)
 - (5) screen 5' 94'
(length) (depth to top)
1 1/4" 5/8"
(size) (material)
 - (6) pump 1" 300
(HP) (yield gpm)

(type power)
 - (7) electric log
(yes or no)

(organization running log)
 - (8) how well bottom plugged B. Wash

CODED


FEB 12 1968

MISS. BD. OF
WATER COM.

DRILLERS REMARKS:

If well telescopes please sketch and show depths.

GROUND LEVEL

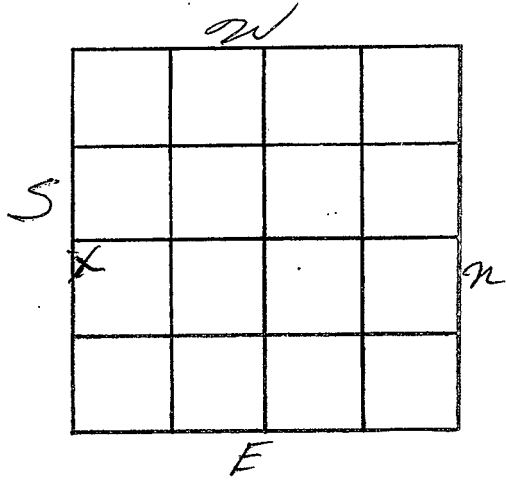

SECTION 1

Please indicate well location X.

ADDITIONAL INFORMATION

If more than one screen, show locations of each on sketch.