

Newton
E20
4-9-68

MISSISSIPPI
BOARD OF WATER COMMISSIONERS
416 North State Street
Jackson, Mississippi 39201

CODED

WATER WELL DRILLERS LOG

4/9 1968 Compass Drilling Co Newton
date well completed firm name county well located

LANDOWNER: Suey Horton
Combsville Route 114
Miss
(mailing address)

description of formations encountered	from	to
<u>Sand sil</u>	<u>0</u>	<u>30</u>
<u>Clay</u>	<u>30</u>	<u>40</u>
<u>Shale</u>	<u>40</u>	<u>103</u>

WELL LOCATION:
sec. 16 T. 7 N R. 10 E
S W
1 miles E of Combsville
(distance) (direction) (nearest town)

WELL PURPOSE: Home
(home, irrigation, municipal, industrial)

WELL COMPLETION DATA:

- (1) diameter (inches) 2"
- (2) total depth (feet) 63
- (3) static water level (feet) 29' below top of ground.
- (4) casing Steel, 60,
(material) (depth)
 if telescope see back.
(size)
- (5) screen 3, 60
(length) (depth to top)
1/4, 7/8
(size) (material)
- (6) pump 1/2 200
(HP) (yield gpm)

(type power)
- (7) electric log X
(yes or no)

(organization running log)
- (8) how well bottom plugged 15' 21/2"

CODED


FEB 12 1969

MISS. BD. OF
WATER COMMISSIONERS

DRILLERS REMARKS:

If well telescopes please sketch and show depths.

GROUND LEVEL

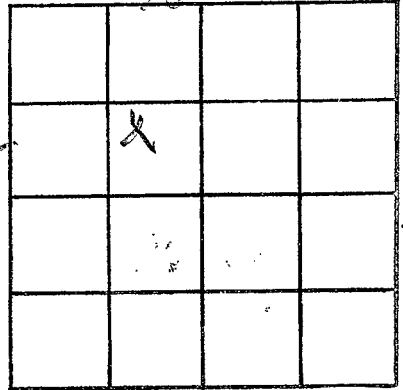

SECTION 16

Please indicate well location X.

ADDITIONAL INFORMATION

If more than one screen,
show locations of each on sketch.