

Newton  
E 21  
4-24-68

MISSISSIPPI  
BOARD OF WATER COMMISSIONERS  
416 North State Street  
Jackson, Mississippi 39201

CODED

WATER WELL DRILLERS LOG

4-54 19 Common Drilling Newton  
date well completed 68 firm name county well located

LANDOWNER: D.D. Blackburn

description of formations encountered	from	to
<u>Bank Clay</u>	<u>0</u>	<u>40</u>
<u>Dark Clay</u>	<u>40</u>	<u>78</u>
<u>Sand</u>	<u>78</u>	<u>95</u>

R#1 Newton  
Missi  
(mailing address)

WELL LOCATION:  
sec. 13 T. 7 N R. 10 E  
S W  
1/2 miles E of Newton  
(distance) (direction) (nearest town)

WELL PURPOSE: Home  
(home, irrigation, municipal, industrial)

WELL COMPLETION DATA:

- (1) diameter (inches) 2 1/2
- (2) total depth (feet) 95
- (3) static water level (feet) 60 below above top of ground.
- (4) casing 5 1/2, 90  
(material), (depth)  
         if telescope see back.  
(size)
- (5) screen 4, 90  
(length) (depth to top)  
1 1/2, 5 1/2  
(size) (material)
- (6) pump 1" 400  
(HP) (yield gpm)  
          
(type power)
- (7) electric log           
(yes or no)  
          
(organization running log)
- (8) how well bottom plugged

CODED


FEB 12 1969

MISS. BD. OF  
WATER COMM.

DRILLERS REMARKS:

If well telescopes please sketch and show depths.

GROUND LEVEL

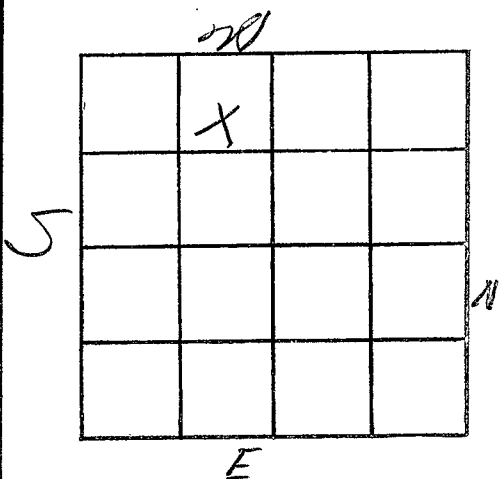

SECTION 13

Please indicate well location X.

ADDITIONAL INFORMATION

If more than one screen, show locations of each on sketch.