

Two different settings in this hole.

Newton
E 23a
8-25-69

MISSISSIPPI
BOARD OF WATER COMMISSIONERS
416 North State Street
Jackson, Mississippi 39201
WATER WELL DRILLERS LOG

COOPER

July 25 1969 TERRU DRILLING Co NEWTON
date well completed firm name county well located

LANDOWNER:

CONNELLY INDIAN School
CONNELLY, Miss
(mailing address)

description of formations encountered

description of formations encountered	from	to
RED SAND	0	22
YELLOW SAND	22	55
BLUE dirt	55	90
SANDY SHALE	90	180
SAND	180	200
SHALE	200	260
SAND	260	330
MS CHAY	330	400
GREEN SAND	400	425
SAND & ROCK	425	460
Tough clay	460	500
" "	500	513
SAND	513	545
ROCK & CHAY	545	617
SAND	617	640

WELL LOCATION:

sec. 16 T 7 N R 10 E
S W
9 miles NE of LAKE, Miss
(distance) (direction) (nearest town)

WELL PURPOSE: School
(home, irrigation, municipal, industrial)

WELL COMPLETION DATA:

- (1) diameter (inches) 8"
- (2) total depth (feet) 638
- (3) static water level (feet) 196' below above top of ground.
- (4) casing BLK, 600' (material) (depth)
6" (size) If telescope see back.
- (5) screen 21', 617' (length) (depth to top)
6", STAINLESS (size) (material)
- (6) pump 15 HP, 138 (yield gpm)

Submerga (type power)

(7) electric log YES (yes or no)

SCHLUMBERGER (organization running log)

(8) how well bottom plugged WASH VALVE


DRILLERS REMARKS:

WELL yield 3 gpf
DRAWN IN

REC'D 9/9/69
LAWSON, GE
WATER BOARD

If well telescopes please sketch and show depths.

GROUND LEVEL

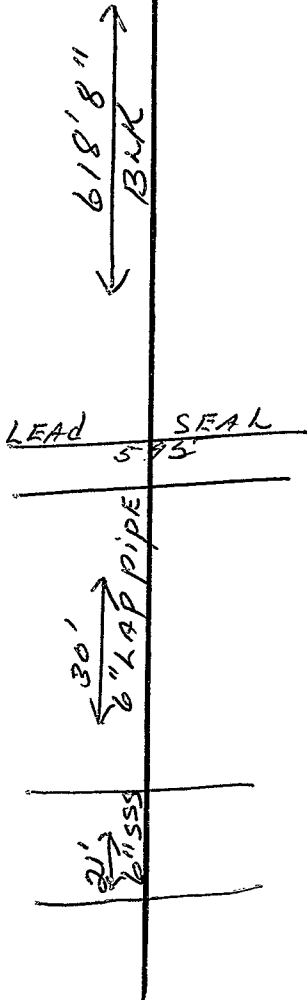

SECTION 16

Please indicate well location X.

ADDITIONAL INFORMATION

If more than one screen, show locations of each on sketch.