

Wood

MISSISSIPPI
BOARD OF WATER COMMISSIONERS
416 North State Street
Jackson, Mississippi 39201

WATER WELL DRILLERS LOG

Newton
E 24
7-68

7-16-68
date well completed

McDONALD & HILL
firm name

NEWTON
county well located

LANDOWNER: S.B. MAYES

DECATUR MISS

(mailing address)

description of formations encountered

from

to

CLAY	0	18
SAND ST CLAY	18	60
SAND	60	215
SHALE & ROCK	215	275
SAND	275	315

WELL LOCATION:

sec. 15 T-7 N R-10 E
S W
7 miles WEST of DECATUR
(distance) (direction) (nearest town)

WELL PURPOSE: HOME
(home, irrigation, municipal, industrial)

WELL COMPLETION DATA:


- (1) diameter (inches) 4"
- (2) total depth (feet) 315
- (3) static water level (feet) 120 below top of ground.
- (4) casing BLK 231' (material) (depth)
4" (size) if telescope see back.
- (5) screen (length) (depth to top)
(size) (material)
- (6) pump 34 10 (HP) (yield gpm)
220 (type power)
- (7) electric log NO (yes or no)
(organization running log)
- (8) how well bottom plugged OPEN

DRILLERS REMARKS:

REG 20 1968
MISSISSIPPI BOARD OF WATER COMMISSIONERS

If well telescopes please sketch and show depths.

GROUND LEVEL

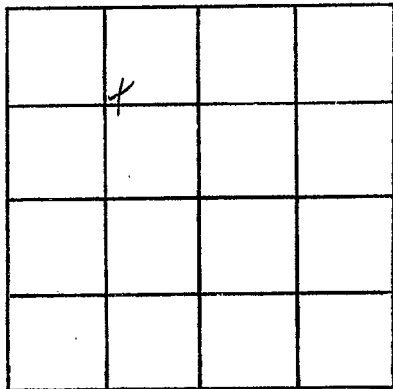

SECTION _____

Please indicate well location X.

ADDITIONAL INFORMATION

If more than one screen,
show locations of each on sketch.