

Newton
E 25
7-68

MISSISSIPPI
BOARD OF WATER COMMISSIONERS
416 North State Street
Jackson, Mississippi 39201

WATER WELL DRILLERS LOG

7.25.68, McDONALD + HILL NEWTON
date well completed firm name county well located

LANDOWNER: A.L. EASON

R#1 DECATUR

(mailing address)

WELL LOCATION:

sec. 13 T 7 N R 10 E
7 miles WEST of DECATUR
(distance) (direction) (nearest town)

WELL PURPOSE: HOME
(home, irrigation, municipal, industrial)

WELL COMPLETION DATA:

- (1) diameter (inches) 4 1/2
- (2) total depth (feet) 300'
- (3) static water level (feet) 110 below top of ground.
- (4) casing BLK 2-10'
(material) (depth)
4" if telescope see back.
(size)
- (5) screen _____
(length) (depth to top)
(size) (material)
- (6) pump 2 10
(HP) (yield gpm)
220
(type power)
- (7) electric log NO
(yes or no)
(organization running log)
- (8) how well bottom plugged OPEN

description of formations encountered

from to


CLAY ST SAND	0	30
SHALE	30	82
SAND ST. SHALE	82	195
SHALE	195	250
SAND	250	270
SAND	270	300

DRILLERS REMARKS:

JUL 29 1968
MISS. BOARD OF
WATER COMMISSIONERS

If well telescopes please sketch and show depths.

GROUND LEVEL

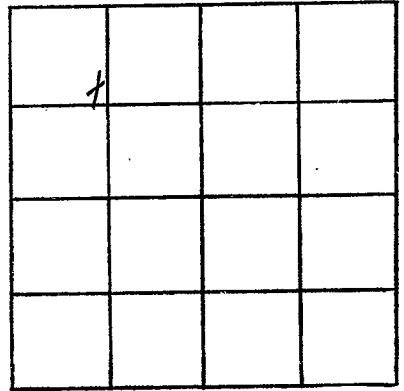

SECTION _____

Please indicate well location X.

ADDITIONAL INFORMATION

If more than one screen,
show locations of each on sketch.