

Newton
Grid - E26
Jan 1970

MISSISSIPPI
 BOARD OF WATER COMMISSIONERS
 416 North State Street
 Jackson, Mississippi 39201

CODED

WATER WELL DRILLERS LOG

Jan 19 70 Wilkinson Newton
 date well completed firm name county well located

LANDOWNER: ~~A.A. Crane~~
R.A.

description of formations encountered	from	to
<u>Yellow Clay</u>	<u>0</u>	<u>20</u>
<u>lex clay & sand</u>	<u>20</u>	<u>35</u>
<u>gray clay</u>	<u>35</u>	<u>50</u>
<u>black & brown</u>	<u>50</u>	<u>85</u>
<u>brown & black</u>	<u>85</u>	<u>90</u>
<u>sand</u>	<u>90</u>	<u>140</u>

Conhatta Miss
 (mailing address)

WELL LOCATION:
 sec. 22 T 7 N R 10 E
4 miles E of Conhatta
 (distance) (direction) (nearest town)

WELL PURPOSE: home
 (home, irrigation, municipal, industrial)

WELL COMPLETION DATA:

- (1) diameter (inches) 7
- (2) total depth (feet) 131
- (3) static water level (feet) 78 ^{below}/_{above} top of ground.
- (4) casing GALV, 126
 (material) (depth)
 _____ if telescope see back.
 (size)
- (5) screen 5, 131
 (length) (depth to top)
2, Stainless
 (size) (material)
- (6) pump 1 Jet 6
 (HP) (yield gpm)
Elec
 (type power)
- (7) electric log NO
 (yes or no)
- _____ (organization running log)

(8) how well bottom plugged 2 BWG

DRILLERS REMARKS:


MAR 10 1970

MISS. BD. OF
 WATER COMM.

CODED

If well telescopes please sketch and show depths.

GROUND LEVEL

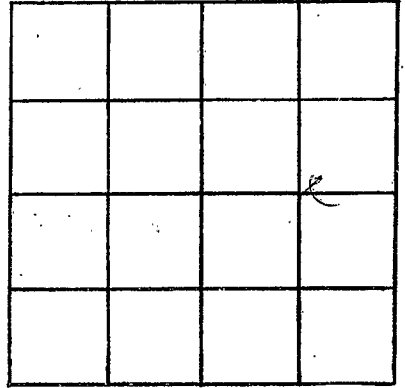

SECTION 22

Please indicate well location X.

ADDITIONAL INFORMATION

If more than one screen,
show locations of each on sketch.