

MISSISSIPPI
BOARD OF WATER COMMISSIONERS
416 North State Street
Jackson, Mississippi 39201

WATER WELL DRILLERS LOG

CODED
CODED

Newton
E 27
1-70

Jan 19 70 Wilkinson Drilling Newton
date well completed firm name county well located

LANDOWNER: M. R. Blackwell

description of formations encountered

from to

Carrollhatta Miss
(mailing address)

Red clay sand 0 66
Clay & Rock 180
Shale & Sand 180 215
Fine sand 215 225
brown clay & sand 225 245
SAND 245 314

WELL LOCATION:

sec. 16 T 7 N R. 10 E
1 miles E of Carrollhatta
(distance) (direction) (nearest town)

WELL PURPOSE: home
(home, irrigation, municipal, industrial)

WELL COMPLETION DATA:

- (1) diameter (inches) 2
- (2) total depth (feet) 300
- (3) static water level (feet) 147 ^{below}/_{above} top of ground.
- (4) casing Galv., 296,
(material) (depth)
if telescope see back.
(size)
- (5) screen 4, 300
(length) (depth to top)
2, Stainless
(size) (material)
- (6) pump 1 1/2 Tot. 6
(HP) (yield gpm)
Elec
(type power)
- (7) electric log NO
(yes or no)

CODED

(organization running log)

MAR 10 1970


(8) how well bottom plugged 2 B.W.

MISS. BD. OF
WATER COMM.

DRILLERS REMARKS:

If well telescopes please sketch and show depths.

GROUND LEVEL

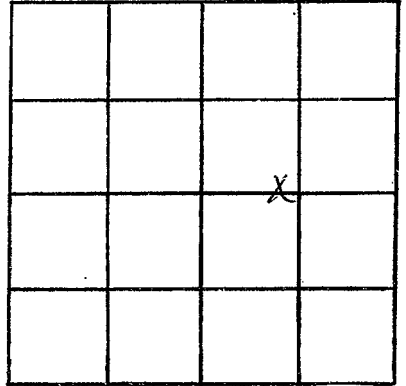

SECTION 16

Please indicate well location X.

ADDITIONAL INFORMATION

If more than one screen,
show locations of each on sketch.