

Newton
E 28
1-29-70

MISSISSIPPI
 BOARD OF WATER COMMISSIONER
 416 North State Street
 Jackson, Mississippi 39201

CODED

WATER WELL DRILLERS LOG

1-29-70 1970 RR Nicholson Newton
 date well completed firm name county well located

LANDOWNER: Oreal Vance
Union
Miss.
 (mailing address)

description of formations encountered	from	to
<u>Clay & Sand</u>	<u>0</u>	<u>40</u>
<u>Sand</u>	<u>40</u>	<u>55</u>
<u>Blue dirt</u>	<u>55</u>	<u>160</u>
<u>Shell & dirt</u>	<u>160</u>	<u>189</u>
<u>rock</u>	<u>189</u>	<u>191</u>
<u>Blue dirt</u>	<u>191</u>	<u>220</u>
<u>Water Sand</u>	<u>220</u>	<u>250</u>

WELL LOCATION:
 sec. 14 T 7 N R 10 E
9 mi. miles west of Union
 (distance) (direction) (nearest town)

WELL PURPOSE: home
 (home, irrigation, municipal, industrial)

- WELL COMPLETION DATA:
- (1) diameter (inches) 4 1/4
 - (2) total depth (feet) 250
 - (3) static water level (feet) 98 below top of ground.
 - (4) casing ASB 189
 (material) (depth)
2" If telescope see back.
 (size)
 - (5) screen no
 (length) (depth to top)
 (size) (material)
 - (6) pump 1 8
 (HP) (yield gpm)
Elect.
 (type power)
 - (7) electric log no
 (yes or no)
 (organization running log)
 - (8) how well bottom plugged open

CODED


JUL 24 1970

MISS. Bd. of
 WATER COMMISSIONERS

DRILLERS REMARKS:

If well telescopes please sketch and show depths.

GROUND LEVEL

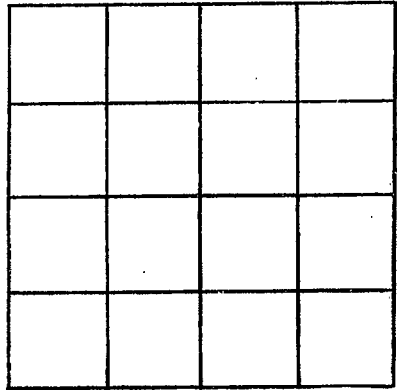

SECTION _____

Please indicate well location X.

ADDITIONAL INFORMATION

A series of horizontal lines for recording additional information, starting below the 'ADDITIONAL INFORMATION' header and extending to the bottom of the page.

If more than one screen, show locations of each on sketch.