

NEWTON
E 29
10-16-70

MISSISSIPPI
 BOARD OF WATER COMMISSIONERS
 416 North State Street
 Jackson, Mississippi 39201

CODED

WATER WELL DRILLERS LOG

10-16-70 19 McDONALD HILL NEWTON
 date well completed firm name county well located

LANDOWNER:
EDWARD WARE
PAI LAKE MISS
 (mailing address)

WELL LOCATION:
 sec. 19 T. 7 N. R. 10 E
8 miles North of LAKE
 (distance) (direction) (nearest town)

WELL PURPOSE: HOME
 (home, irrigation, municipal, industrial)

- WELL COMPLETION DATA:
- (1) diameter (inches) 4"
 - (2) total depth (feet) 625'
 - (3) static water level (feet) 170' below top of ground.
 - (4) casing BLK 510'
 (material) (depth)
4"
 (size) if telescope see back.
 - (5) screen
 (length) (depth to top)
 (size) (material)
 - (6) pump 1 1/2 90
 (HP) (yield gpm)
ELECTRIC
 (type power)
 - (7) electric log NO
 (yes or no)
NO
 (organization running log)
 - (8) how well bottom plugged OPEN

description of formations encountered	from	to
Clay	0	18
Sand Clay	18	40
Shale	40	60
Sand	60	160
Shale	160	240
Sand	240	300
Shale	300	330
Sand	330	440
Sandy Shale	440	500
Shale	500	575
Sand	575	625

CODED


OCT 22 1970

DRILLERS REMARKS:

MISS. BD. OF
 WATER COMM.

If well telescopes please sketch and show depths.

GROUND LEVEL

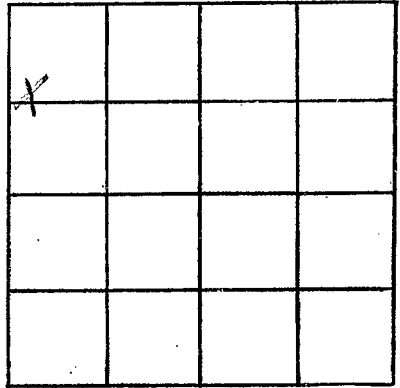

SECTION _____

Please indicate well location X.

ADDITIONAL INFORMATION

If more than one screen, show locations of each on sketch.