

Newton
E 30
7-29-71

MISSISSIPPI
 BOARD OF WATER COMMISSIONERS
 416 North State Street
 Jackson, Mississippi 39201

WATER WELL DRILLERS LOG

CODED

7-29-71 19 Newton COMANS Drilling Service Newton
 date well completed firm name county well located

LANDOWNER: W.M. Sharp
Combatta R.H. Minn
 (mailing address)

WELL LOCATION:
 sec. 29 T 9 N R 11 E
2 miles South of Combatta
 (distance) (direction) (nearest town)

WELL PURPOSE: Home
 (home, irrigation, municipal, industrial)

WELL COMPLETION DATA:
 (1) diameter (inches) 2"
 (2) total depth (feet) 415
 (3) static water level (feet) 30 below above top of ground.
 (4) casing Steel B15
 (material) (depth)
 (size) if telescope see back.
 (5) screen (length) (depth to top)
 (size) (material)
 (6) pump 1 4
 (HP) (yield gpm)
Electric
 (type power)
 (7) electric log Mo
 (yes or no)
 (organization running log)
 (8) how well bottom plugged Open

description of formations encountered	from	to
Clay	0	19
SAND	19	28
Clay	28	198
SAND	198	235
Clay	235	370
Rock & Shell	370	400
SAND	400	415

CODED


APR 12 1972

MISS. BD. OF
 WATER COMMISSIONERS

DRILLERS REMARKS:
Open Bottom

If well telescopes please sketch and show depths.

GROUND LEVEL

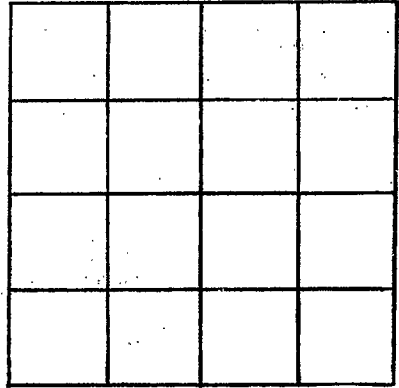

SECTION _____

Please indicate well location X.

ADDITIONAL INFORMATION

If more than one screen, show locations of each on sketch.