

**Newton**  
**E 32**  
**9-13-72**

MISSISSIPPI  
 BOARD OF WATER COMMISSIONERS  
 416 North State Street  
 Jackson, Mississippi 39201

**CODED**

WATER WELL DRILLERS LOG

9-13 date well completed      U. L. Welch firm name      Newton county well located

LANDOWNER: ~~E. Ledlow~~  
E. Ledlow  
Lumaine Miss  
 (mailing address)

WELL LOCATION:  
 sec. 34 T. 70 N. R. 10 E.  
6 miles NW of Lumaine  
 (distance) (direction) (nearest town)

WELL PURPOSE: stock  
 (home, irrigation, municipal, industrial)

- WELL COMPLETION DATA:
- (1) diameter (inches) 3 4
  - (2) total depth (feet) 280
  - (3) static water level (feet) 25 below top of ground.
  - (4) casing 4" steel (material) (depth)
  - (size) if telescope see back.
  - (5) screen 10' (length) (depth to top)
  - 2" 5 steel (size) (material)
  - (6) pump (HP) (yield gpm)
  - (type power)
  - (7) electric log (yes or no)
  - (organization running log)
  - (8) how well bottom plugged

description of formations encountered	from	to
chalky	0	18
blue & shell	18	76
Brown & clay	76	120
Sand	120	180

**CODED**


SEP 27 1972

MISS. BOARD OF WATER COMMISSIONERS

DRILLERS REMARKS:  
Mr. Ledlow is going to install a windmill his self.

If well telescopes please sketch and show depths.

GROUND LEVEL

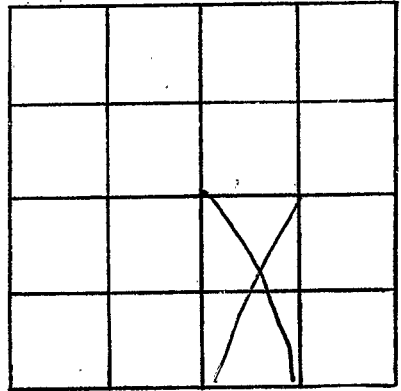

SECTION \_\_\_\_\_

Please indicate well location X.

ADDITIONAL INFORMATION

If more than one screen,  
show locations of each on sketch.