

Newton
E 33
9-5-72

MISSISSIPPI
BOARD OF WATER COMMISSIONERS
416 North State Street
Jackson, Mississippi 39201

WATER WELL DRILLERS LOG

CODED

9-5-1972 date well completed
Simon H & A firm name
Newton county well located

LANDOWNER: Justin Lewis
Simon H & A
(mailing address)

description of formations encountered	from	to
Clay	0	80
Sand	80	130
Clay	130	198
Sand	198	255
Red + Shell	255	298
Clay	298	285
Sand	285	300

WELL LOCATION:
sec. 11 T. 7 N. R. 10 E.
10 miles S-E of Sebaston
(distance) (direction) (nearest town)

WELL PURPOSE: Home
(home, irrigation, municipal, industrial)

WELL COMPLETION DATA:

- (1) diameter (inches) 2"
- (2) total depth (feet) 300
- (3) static water level (feet) 85 below above top of ground.
- (4) casing Steel 231
(material) (depth)
(size) If telescope see back.
- (5) screen (length) (depth to top)
(size) (material)
- (6) pump 1 1/2 5
(HP) (yield gpm)
F
(type power)
- (7) electric log No
(yes or no)
(organization running log)
- (8) how well bottom plugged


DRILLERS REMARKS:
open bottom

CODED

SEP 28 1972
MISS. WATER BOARD

If well telescopes please sketch and show depths.

GROUND LEVEL

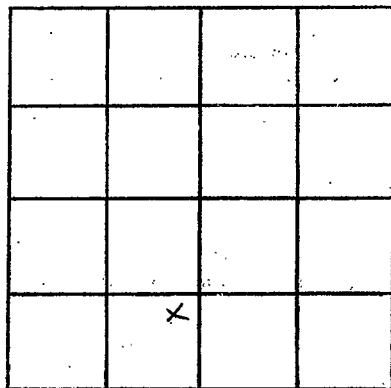

SECTION 11

Please indicate well location X.

ADDITIONAL INFORMATION

If more than one screen,
show locations of each on sketch.