

Newton
E 34
2-73

MISSISSIPPI
 BOARD OF WATER COMMISSIONERS
 416 North State Street
 Jackson, Mississippi 39201

CODED

WATER WELL DRILLERS LOG

Newton

Feb. 19 *73* *R.B. Wilkerson & Son, Inc.* ~~Newton~~
 date well completed firm name county well located

LANDOWNER: *Billie Henderson*
Corbett, Miss
 (mailing address)

description of formations encountered	from	to
<i>Yellow Clay</i>	<i>0</i>	<i>10</i>
<i>Red sand</i>	<i>10</i>	<i>33</i>
<i>Blue Clay</i>	<i>33</i>	<i>195</i>
<i>Layer of Gravel</i>	<i>195</i>	<i>210</i>
<i>White, Blue, Sand</i>	<i>210</i>	<i>236</i>

WELL LOCATION:
 sec. *17* T. *1* N. R. *10* E
1/2 mi. miles *South* of *Newton*
 (distance) (direction) (nearest town)

WELL PURPOSE: *Private*
 (home, irrigation, municipal, industrial)

- WELL COMPLETION DATA:
- (1) diameter (inches) *2 1/2*
 - (2) total depth (feet) *236*
 - (3) static water level (feet) *110* below top of ground.
 - (4) casing *Galv* *236*
 (material) (depth)
 (size) if telescope see back.
 - (5) screen *5'*
 (length) (depth to top)
2" *Galv*
 (size) (material)
 - (6) pump *2H* *15*
 (HP) (yield gpm)
Electric
 (type power)
 - (7) electric log *Yes*
 (yes or no)
 (organization running log)
 - (8) how well bottom plugged *Not plugged*


CODED

MAR 9 1973

DRILLERS REMARKS:

If well telescopes please sketch and show depths.

GROUND LEVEL

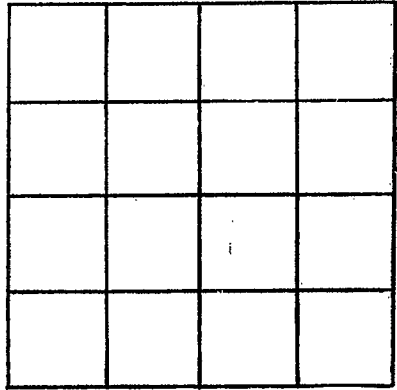

SECTION _____

Please indicate well location X.

ADDITIONAL INFORMATION

A series of horizontal lines for recording additional information, starting below the 'ADDITIONAL INFORMATION' header and extending to the bottom of the page.

If more than one screen, show locations of each on sketch.